


CERTIFIED RECORD OF LAND CORNER MONUMENTATION

History of original corner establishment:

The corner was originally established by Authur B. Brown under Mineral Survey No. 547 during September 1903. The original notes state that at the corner a 5' long by 6" square marked post was set 2' in the ground and surrounded with a mound of earth and stone from which:

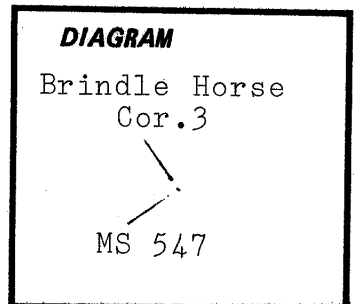

A 20" red fir bears N45°15'W-20' marked B.T Cor. No. 3, 547.

A 30" red fir bears S64°50'E-56.5' marked B.T. Cor. 3, 547.

No record of subsequent remonumentation appears in county records.

Description of corner evidence found:

A mound of stones and the remains of a rotted wood post from which:

A 28" red fir bears N45 1/4°W-21.0' with healed blaze.

A 28" fed fir stump bears S64 3/4°E-56.2' with some visable scribing.

Description of monument and accessories | established to perpetuate the original location of this corner:

A 2 1/2" by 30" aluminum pipe with 2 1/2" aluminum cap was set 12" in the ground and surrounded with a mound of stone from which:

A 10" white fir bears N77 1/2°E-38.5' scribed BH-3-547 BT.

Each new bearing tree has a brass washer stamped PLS 1106 nailed to the face of the blaze. Attached sign 54-3 and 54-9 to each bearing tree and painted face of blaze and a 6" red band around each bearing tree.


Set steel fence post with sign 54-9 attached next to monument.

Used steel tape and staff compass with 20°E declination, measured to the center of the braring trees.



This corner was monumented on October 10, 1983.

Cap is marked:

Witness: Jim Bowler

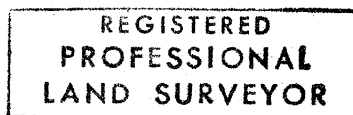

William R. Wells

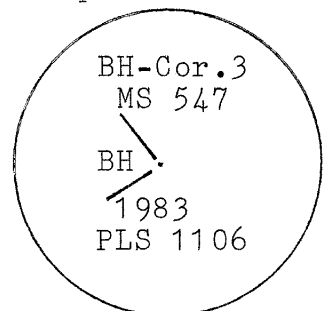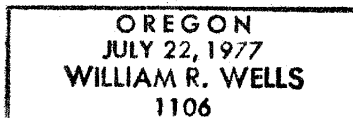

Office of..County..Surveyor..... County of..Baker
State of..Oregon....., I hereby certify that the within instrument was filed in this office
for record on the..... day of....., 19.....

..... by
(COUNTY OFFICIAL) (DEPUTY)

Form R6-7100-57 (9/71)

☆U.S. GOVERNMENT PRINTING OFFICE - 1983-793-276

FILED May 9, 1984

BAKER COUNTY SURVEYOR

SURVEY NO. 10-35-177