


CERTIFIED RECORD OF LAND CORNER MONUMENTATION

History of original corner establishment:

The corner was originally established by Authur B. Brown under Mineral Survey No. 547 during September 1903. The original notes state that at the corner a 5' long by 6" square marked wood post was set 2' in the ground with a mound of earth and stone from which:

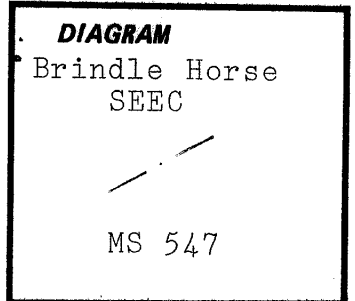

A 3' tamerack bears N42°W-36.5' marked B.T. S.E.C. End B.H. 547.
A 2' white fir bears N21°E-16.5' marked S.E.C. End B.H. 547.

No record of subsequent remonumentation was found in the county records.

Description of corner evidence found:

Found rotted remains of a wood post in a mound of stone from which:

A 24" rotten fir snag bears N22°E-17.4' with visable scribing.
A 42" western larch stump bears N40 1/2°W-38.1' with visable scribing.

Description of monument and accessories | established to perpetuate the original location of this corner:

A 2 1/2" by 30" aluminum pipe with 2 1/2" aluminum cap was set 22" in the ground and surrounded with a mound of stone from which:

A 10" white fir bears N68°E-7.1' scribed B.H.-S.E.E.C.-X BT.
A 11" white fir bears S43 1/2°E-19.5' scribed B.H.-S.E.E.C.-547 BT.

Each new bearing tree has a brass washer stamped PLS 1106 nailed to the face of the blaze. Attached sign 54-3 and 54-9 to each bearing tree and painted face of blaze and a 6" red band around each bearing tree.



Set steel fence posts on National Forest Boundary Northeast and Southwest of corner and attached sign 54-2 to both posts and sign 54-9 to one post.

Used steel tape and staff compass with 20°E declination, measured to the center of the bearing trees.

This corner was monumented on September 29, 1983.

Cap is marked:

Witness: Jim Bowler

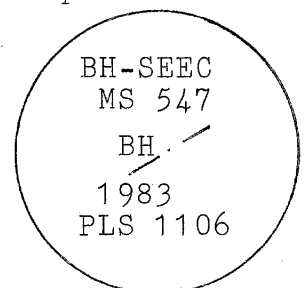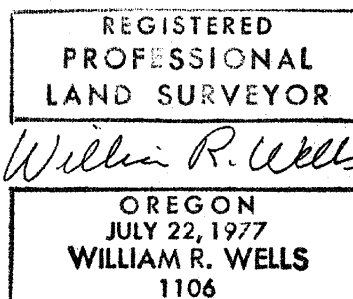

Office of.....County...Surveyor..... County of...Baker.....
State of.....Oregon....., I hereby certify that the within instrument was filed in this office
for record on the..... day of....., 19.....
..... by
(COUNTY OFFICIAL) (DEPUTY)

Form R6-7100-57 (9/71)

☆ U.S. GOVERNMENT PRINTING OFFICE - 1983-793-276

FILED May 9, 1984
BAKER COUNTY SURVEYOR
SURVEY NO. 10-35-178