


CERTIFIED RECORD OF LAND CORNER MONUMENTATION

History of original corner establishment:

The corner was originally established by Authur B. Brown under Mineral Survey No. 547 during September 1903. The original notes state that at the corner a 5' long by 6" square marked post was set 2' in the ground and surrounded with a mound of stone from which:

A 12" White fir bears S29°40'E-89.0' marked B.T. Cor. 1 547.

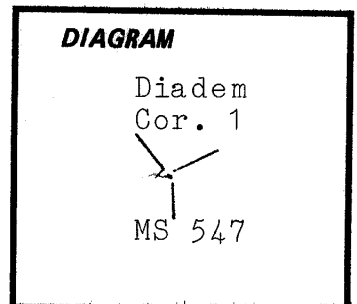

The corner was remonumented by James Hambleton in 1973.

Description of corner evidence found:

Hambleton's 2 1/2" brass cap on 2 1/2" iron pipe protruding 6" from a mound of stone from which:

A 21" white fir bears S29 3/4°E-37.4' with visable scribing.
A 20" red fir bears S17 1/2°W-139.0' with partly healed blaze and visable scribing.

Description of monument and accessories | established to perpetuate the original location of this corner:

Maintained Hambleton's monument by piling more stones around it.

Attached sign 54-3 and 54-9 and painted face of blaze and a 6" red band around each bearing tree.



Set steel fence posts Northwest and Southeast of corner on National Forest Boundary and attached signs 54-2 to both posts and sign 54-9 to one post.

Used steel tape and staff compass with 20°E declination, measured to the center of the bearing trees.

This corner was maintained on September 29, 1983.

Witness: Jim Bowler

Cap is marked:

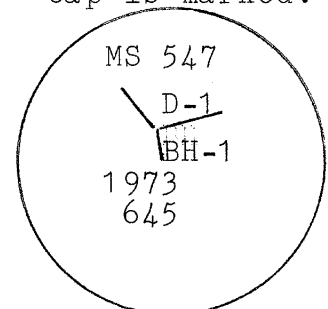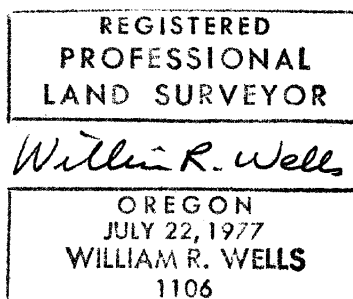

Office of.....County Surveyor..... County of Baker
State of Oregon....., I hereby certify that the within instrument was filed in this office
for record on the..... day of....., 19.....
..... by
(COUNTY OFFICIAL) (DEPUTY)

Form R6-7100-57 (9/71)

☆U.S. GOVERNMENT PRINTING OFFICE - 1983-793-276

FILED May 9, 1984
BAKER COUNTY SURVEYOR
SURVEY NO. 10-35-179