


CERTIFIED RECORD OF LAND CORNER MONUMENTATION

History of original corner establishment:

The corner was originally established by Authur B. Brown under Mineral Survey No. 547 during September, 1903. The original notes state that at the corner a 5' long by 6" square post was set 2' in the ground and surrounded with a mound of earth and stone.

No bearing trees were originally set.

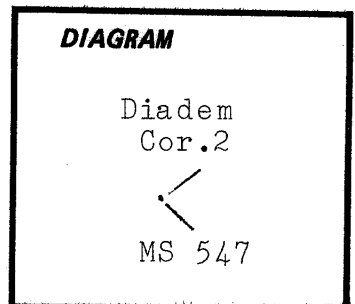

Description of corner evidence found:

None. Hambleton's monument set for the corner bears $S31^{\circ}48'45''W-98.2'$ from the corner we set by the broken boundary method.

Description of monument and accessories | established to perpetuate the original location of this corner:

A 2 1/2" by 30" aluminum pipe with 2 1/2" aluminum cap was set 15" in the ground and surrounded with a mound of stone from which:
A reference monument bears $N5\ 1/2^{\circ}W-11.77'$.
A reference monument bears $N54\ 1/2^{\circ}W-20.59'$.



Reference monuments are 2 1/2" by 30" aluminum pipes with 2 1/2" aluminum caps marked with the distance to the corner point, the corner name and mineral survey number and are stamped "PLS 1106" and "1983".

Set steel fence posts on National Forest Boundary Northeast and Southeast of corner and attached sign 54-2 to both posts and sign 54-9 to one post. Set steel fence post next to each reference monument and attached sign 54-9.


This corner was monumented on September 29, 1983.

Witness: Jim Bowler

Used steel tape and staff compass with $20^{\circ}E$ declination, measured to center of bearing trees.

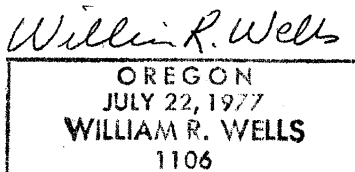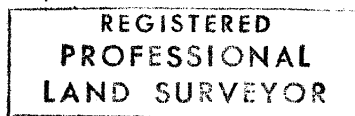

Cap is marked:

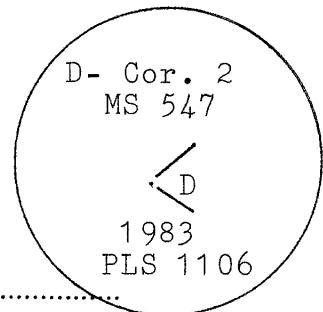

Office of..County..Surveyor..... County of..Baker
State of..Oregon....., I hereby certify that the within instrument was filed in this office
for record on the..... day of....., 19.....
..... by
(COUNTY OFFICIAL) (DEPUTY)

Form R6-7100-57 (9/71)

☆U.S. GOVERNMENT PRINTING OFFICE - 1983-793-276

FILED May 9, 1984
BAKER COUNTY SURVEYOR
SURVEY NO. 10-35-180