


CERTIFIED RECORD OF LAND CORNER MONUMENTATION

History of original corner establishment:

The corner was originally established by Authur B. Brown under Mineral Survey No. 547 during September 1903. The original notes state that at the corner 5' long by 6" square marked post was set 2' in the ground with a mound of earth and stone.

No bearing trees were originally established.

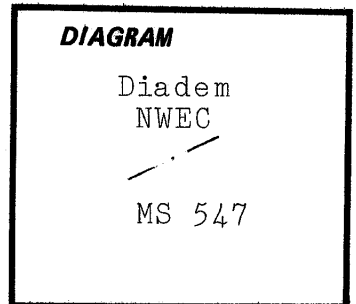

No evidence of subsequent remonumentation was found in county records.

Description of corner evidence found:

The remains of a rotted wood post on a flat spot on a serpentine hillside.

Description of monument and accessories | established to perpetuate the original location of this corner:

A 2 1/2" by 30" aluminum pipe with 2 1/2" aluminum cap was set 15" in the ground and surrounded with a mound of stone from which:
A reference monument bears N77°W-16.36'.
A reference monument bears S15 1/2°W-21.05'.

Reference monuments are 2 1/2" by 30" aluminum pipes with 2 1/2" aluminum caps marked with the distance to the corner point, the corner name and mineral survey number and are stamped "PLS 1106" and "1983".

Set steel fence posts on National Forest Boundary Northeast and Southwest of corner and attached sign 54-2 to both posts and sign 54-9 to one post.


This corner was monumented on Semtember 29, 1983.

Witness: Jim Bowler



A steel fence post with sign 54-9 is set next to each reference monument.

Used steel tape and staff compass with 20°E declination, measured to center of bearing trees.

Cap is marked:

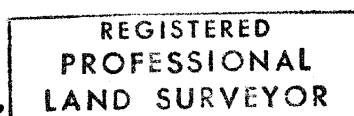

William R. Wells

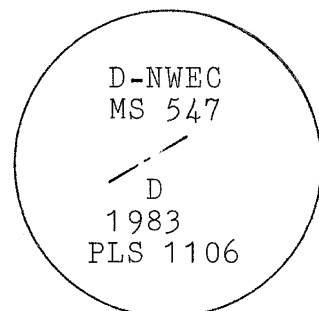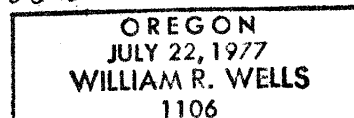

Office of...County Surveyor...County of...Baker
State of...Oregon...I hereby certify that the within instrument was filed in this office
for record on the...day of...19....

(COUNTY OFFICIAL)

(DEPUTY)

Form R6-7100-57 (9/71)

☆U.S. GOVERNMENT PRINTING OFFICE - 1983-793-276

FILED May 9, 1984

BAKER COUNTY SURVEYOR

SURVEY NO. 10-35-183