


CERTIFIED RECORD OF LAND CORNER MONUMENTATION

History of original corner establishment:

James Hambleton originally established the Snow Creek - Brindle Horse Intersection in 1973 for the U. S. Forest Service, and set 2 lodgepole pine bearing trees.

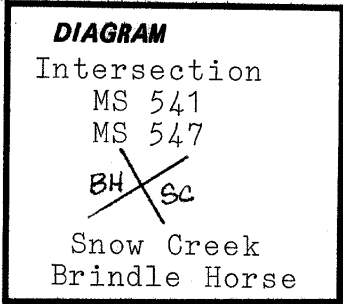

Description of corner evidence found:

Found a 2 1/2 " brass cap on 2 1/2" iron pipe set by Hambleton in 1973 to be located S84°13'W-2.0 from the true intersection point. We also found the two lodgepole pine bearing trees marked by Hambleton.

Description of monument and accessories | established to perpetuate the original location of this corner:

At the true intersection point we set a 2 1/2" by 30" aluminum pipe with 2 1/2" aluminum cap 6" in the ground and surrounded with a mound of stone, from which we reference Hambleton's existing bearing trees:

A 9" lodgepole pine bears S4°E-34.3' scribed MS 547 BH X, with a lower blaze scribed BT, and a brass washer marked "645".
A 10" lodgepole pine bears N69°E-4.6' scribed MS 547 BH X, with lower blaze scribed BT, and a brass washer stamped "645".

Attached sign 54-3 and 54-9 to each bearing tree and painted face of blaze and a 6" red band around each bearing tree.

Set steel fence posts on National Forest Boundary Southwest and Northwest of corner and attached sign 54-2 to each post and sign 54-9 to one post.

Used steel tape and staff compass with 20°E declination, measured to the center of the bearing trees.

This corner was monumented on October 12, 1983.

Witness: Rudy Golbenic.

REGISTERED
PROFESSIONAL
LAND SURVEYOR

William R. Wells

OREGON
JULY 22, 1977
WILLIAM R. WELLS
Baker 1106

Cap is marked:

INTERSECTION
MS 541
MS 547
BH X SC
BH
SC
1983
PLS 1106

Office of.....County Surveyor.....County of.....
State of.....Oregon....., I hereby certify that the within instrument was filed in this office
for record on the..... day of....., 19.....
..... by
(COUNTY OFFICIAL) (DEPUTY)