


CERTIFIED RECORD OF LAND CORNER MONUMENTATION

History of original corner establishment:

James Hambleton originally established the Snow Creek-Brindle Horse Intersection in 1973 for the U.S. Forest Service, and set a fir bearing tree.

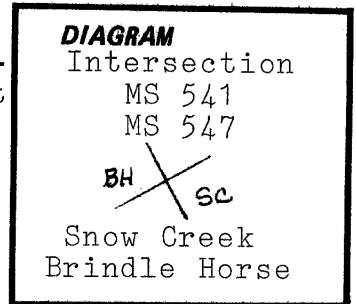

Description of corner evidence found:

Found a 2 1/2" brass cap on a 2 1/2" G.I.P. protruding 12" from a mound of stone. We find that Hambleton's monument falls S63°29'W-1.6' from the location of the line intersection. We maintain Hambleton's monument and note its falling on our survey plat. From Hambleton's monument:

A 10" white fir bears N72 1/2°E-46.4' marked MS 457 BH BT, with a lower blaze marked BT, and a brass washer stamper "645".

Description of monument and accessories | established to perpetuate the original location of this corner:

Maintained Hambleton's monument by piling more stones around it from which:

A 8" red fir bears S47 1/2°E-15.6' scribed INTEX-547-541 BT.

Each new bearing tree has a brass washer stamped PLS 1106 nailed to the face of the blaze. Attached sign 54-3 and 54-9 to each bearing tree and painted face of blaze and a 6" red band around each bearing tree.


Set steel fence posts on National Forest Boundary Northwest and Southwest of corner and attached sign 54-2 to both posts and sign 54-9 to one post.

Used steel tape and staff compass with 20°E declination, measured to the center of the bearing trees.



Cap is marked:

This corner was maintained on October 12, 1983

Witness: Rudy Golbenic

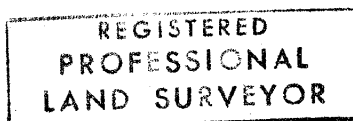

William R. Wells

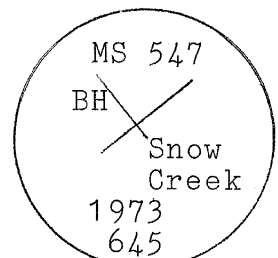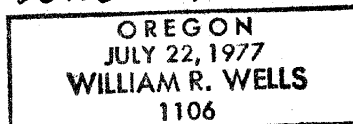

Office of.....County.....Surveyor..... County of.....Baker.....

State of.....Oregon....., I hereby certify that the within instrument was filed in this office
for record on the..... day of....., 19.....

..... by
(COUNTY OFFICIAL) (DEPUTY)