


CERTIFIED RECORD OF LAND CORNER MONUMENTATION

History of original corner establishment:

Virgin Amended Corner 1 was originally established by William W. Elmer under an amended survey of the Virgin Lode Claim during July, 1904. The original notes state that at the corner a 4 1/2' long by 6" square marked pine post was set 18" in the ground and surrounded with a mound of rocks from which:

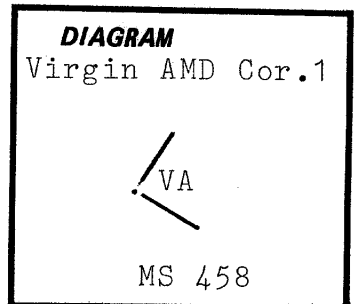

Corner No. 1 of Virgin Lode Original Survey bears N58°52' W-4.14' (Destroyed).

Corner No.5 of Virgin Lode Original Survey bears S58°52'E-10.90' (Destroyed).
A 18" pine tree bears S 36°27' E-39.6' marked B.T.V.-1-458.

The corner was remonumented by James Hambleton in 1973.

Description of corner evidence found:

Hambleton's 2 1/2" brass cap on 2 1/2" G.I.P. set in a mound of stone from which:

A large, down completely rotted ponderosa pine bears S36 1/2°E-40'±, with scribing and measuring nail visible on part of the blaze.
A 14" lodgepole pine bears S42 1/2°W-57.0' with visible scribing.
A 11" lodgepole pine bears S75°E-56.6' with visible scribing.
A stone mound bears S42°W-9'. (Significance unknown).

Description of monument and accessories | established to perpetuate the original location of this corner:

Maintained Hambleton's monument by placing more stones around it.

Set steel fence posts on National Forest Boundary Northeast and Southeast of corner and attached sign 54-2 to both posts and sign 54-9 to one post.


Used steel tape and staff compass with 20°E declination, measured to the center of the bearing trees.

This corner was maintained on July 14, 1983.


Cap is marked:

Witness: Ken Yokom

Virgin No. 1
MS 458

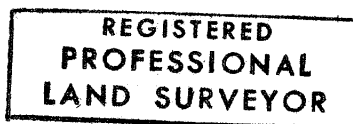

William R. Wells

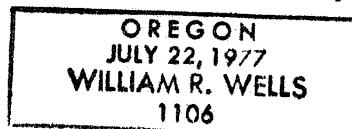

1
1973
645

Office of...County Surveyor.....County of...Baker
State of...Oregon....., I hereby certify that the within instrument was filed in this office
for record on the..... day of....., 19.....

..... by
(COUNTY OFFICIAL)

(DEPUTY)

Form R6-7100-57 (9/71)

☆U.S. GOVERNMENT PRINTING OFFICE - 1983-793-276

FILED May 9, 1984
BAKER COUNTY SURVEYOR
SURVEY NO. 10-35-186