


CERTIFIED RECORD OF LAND CORNER MONUMENTATION

History of original corner establishment:

Virgin Amended Corner 4 was originally established by William W. Elmer under an amended survey of the Virgin Lode Claim during July, 1904. The original notes state that at the corner a 4 1/2' long by 6" square marked pine post was set 18" in the ground and surrounded with a mound of stone from which:

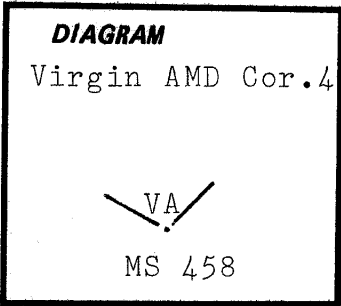

Corner 4 of Virgin Lode Original Survey bears S56°23'W-80.14' (Destroyed).
A 30" fir bears S31°02' W-77.16' marked B.T.V.4 458.
A 12" fir bears S72°12'W-80.1' marked B.T.V.4 458.

The corner was remonumented by James Hambleton in 1973.

Description of corner evidence found:

Hambleton's 2 1/2" brass cap on a 2 1/2" G.I.P. set in a mound of stone from which:

A 10" dead lodgepole pine bears N69°W-36.4' with visable scribing.
A 16" white fir bears S2 1/2°E-28.5' with visable scribing on a partly healed blaze.
A 19" white fir with healed blaze bears S72 1/4°W-80.5'.
A 33" white fir bears S31°W-78.5' with healed blaze facing corner and an open side blaze facing the original Virgin Cor. 4 position.

Description of monument and accessories | established to perpetuate the original location of this corner:

Maintained Hambleton's monument by placing more stones around it.

Set steel fence post on National Forest Boundary Northeast and Northwest of corner and attached sign 54-2 to both posts and sign 54-9 to one post.


Used steel tape and staff compass with 20°E declination, measured to the center of the bearing trees.

This corner was maintained on July 14, 1983.

Cap is marked:

Witness: Ken Yokom

Virgin No.4
MS 458

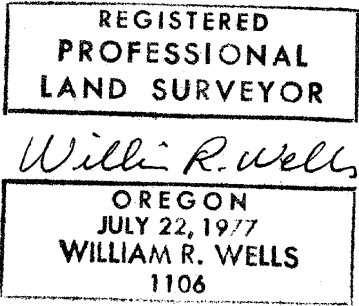

4
1973
645

Office of...County Surveyor.....County of...Baker
State of...Oregon....., I hereby certify that the within instrument was filed in this office
for record on the..... day of....., 19....
..... by
(COUNTY OFFICIAL) (DEPUTY)