


CERTIFIED RECORD OF LAND CORNER MONUMENTATION

History of original corner establishment:

None.

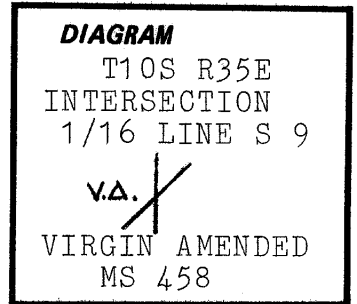

Description of corner evidence found:

None.

Description of monument and accessories I established to perpetuate the
original location of this corner:

A 2 1/2" by 30" aluminum pipe with 2 1/2" aluminum cap was set 22" in the ground and surrounded with a mound of stone from which:

A 13" white fir bears N33°E-35.6' scribed INTEX.-S9-V.A.-MS 458 BT.

A 12" western larch bears S39 1/2°W-25.1' scribed INTEX.-S9-V.A.-MS 458 BT.

Each new bearing tree has a brass washer stamped PLS 1106 nailed to the face of the blaze. Attached sign 54-3 and 54-9 to each bearing tree and painted face of blaze and a 6" red band around each bearing tree.


Set steel fence posts on National Forest Boundary South and Southwest of corner and attached sign 54-2 to both posts and sign 54-9 to one post.

Used steel tape and staff compass with 20°E declination, measured to the center of the bearing trees.


This corner was monumented on August 11, 1983.

Cap is marked:

Witness: Ken Yokom

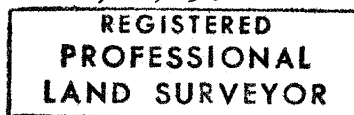

William R. Wells

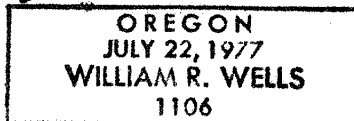

T10S R35E
INTERSECTION
1/16 LINE S9

V.A. /
V.A. MS 458
1983
PLS 1106

Office of... County Surveyor... County of... Baker
State of... Oregon... I hereby certify that the within instrument was filed in this office
for record on the... day of... , 19....
..... by
(COUNTY OFFICIAL) (DEPUTY)

Form R6-7100-57 (9/71)

☆ U.S. GOVERNMENT PRINTING OFFICE - 1983-793-276

FILED May 9, 1984

BAKER COUNTY SURVEYOR

SURVEY NO. 10-35-190