


CERTIFIED RECORD OF LAND CORNER MONUMENTATION

History of original corner establishment:

The corner was originally established by Arthur Philbrick under Mineral Survey No. 548 during September 1903. The original notes state that at the corner a 4' long by 4" square marked tamarack post was set 18" in the ground and surrounded with a mound of earth from which:

A 36" tamarack bears N80°33'E-54.4'.
A 8" red fir bears S75°51'W-45.1'.
Each marked B.T.C.P.2-548.

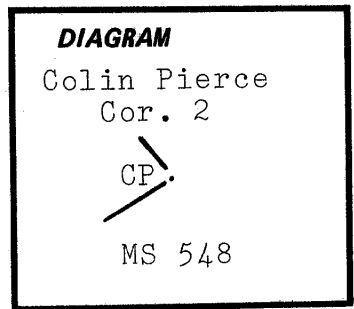

The corner was remonumented by Leland Myers in 1972.

Description of corner evidence found:

Myer's 2 1/2" aluminum cap on a 1" G.I.P. set in a mound of stone from which:

A 25" high butted western larch stump bears N80 1/2°E-7.0' with open blaze and visible scribing.
A 15" red fir bears S78 1/2°W-45.5' with mostly healed blaze.

Note: The original distance to the bearing tree shown in the original notes must be in error. Philbrick must have meant 5.44' (measured to face of blaze) instead of 54.4'.

Description of monument and accessories | established to perpetuate the original location of this corner:

Maintained Myer's monument by placing more stones around it. From the monument:

A 11" red fir bears S49 1/2°E-26.3' scribed C.P.-2-548 BT.

Each new bearing tree has a brass washer stamped PLS 1106 nailed to the face of the blaze. Attached sign 54-3 and 54-9 to each bearing tree and painted face of blaze and a 6" red band around each bearing tree.

Set steel fence post next to monument and attached sign 54-9.


Used steel tape and staff compass with 20°E declination, measured to the center of the bearing trees.

Cap is marked:


This corner was maintained on July 13, 1983.

ORLS 699

Witness: Ken Yokom

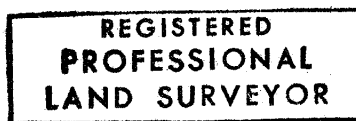

William R. Wells

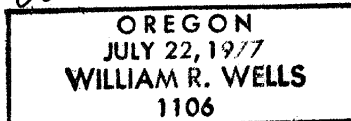

Colin
Pierce 2
MS 548

S9 S10
M
1972

Office of...County...Surveyor..... County of...Baker.....
State of...Oregon....., I hereby certify that the within instrument was filed in this office
for record on the..... day of....., 19.....
..... by
(COUNTY OFFICIAL) (DEPUTY)

Form R6-7100-57 (9/71)

☆U.S. GOVERNMENT PRINTING OFFICE - 1983-793-276

FILED May 9, 1984
BAKER COUNTY SURVEYOR
SURVEY NO. 10-35-194