


CERTIFIED RECORD OF LAND CORNER MONUMENTATION

History of original corner establishment:

The corner was originally established by Arthur Philbrick under Mineral Survey No. 548 during September 1903. The original notes state that at the corner a 4' long by 4" square marked black pine post was set 18" in the ground and surrounded with a mound of earth from which:

A 4" red fir bears N44°E-11.5'
A 10" red fir bears N78°22'W-19.94'
Each marked C-P-S-C-548 BT.

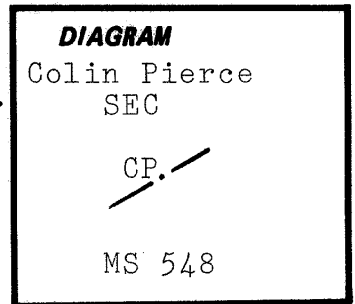

No record of subsequent remonumentation appears in county records.

Description of corner evidence found:

A 5" square wood post set in a mound of stones from which:
A 24" red fir bears N44°E-12.1' with healed blaze.

Description of monument and accessories | established to perpetuate the original location of this corner:

Set a 2 1/2" by 30" aluminum pipe with 2 1/2" aluminum cap 15" in the ground and surrounded with a mound of stones from which:

A 10" white fir bears S12 1/2°E-12.4' scribed C.P.-S.E.C.-548 BT.

Placed wood post on stone mound.


Each new bearing tree has a brass washer stamped PLS 1106 nailed to the face of the blaze. Attached sign 54-3 and 54-9 to each bearing tree and painted face of blaze and a 6" red band around each bearing tree.

Set steel fence post next to corner and attached sign 54-9.

Used steel tape and staff compass with 20°E declination, measured to the center of the bearing trees.

This corner was monumented on July 13, 1983.

Witness: Ken Yokom

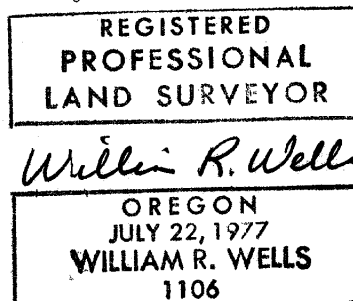

Cap is marked:

C.P. S.E.C.
MS 548
C.P.
1983
PLS 1106

Office of.....County Surveyor.....County of.....Baker.....
State of.....Oregon....., I hereby certify that the within instrument was filed in this office
for record on the..... day of....., 19.....
..... by
(COUNTY OFFICIAL) (DEPUTY)

FILED May 9, 1984
COUNTY SURVEYOR
SURVEY NO. 10-35-196