


LEGEND

- () RECORD PER MINERAL SURVEY NO. 458
- [] RECORD PER WELLS SURVEY, GRANT COUNTY FILE NO. 809
- ⊗ FOUND 2 1/2" X 30" G.I. PIPE WITH 2 1/2" BRASS CAP ATTACHED SET FROM EXISTING EVIDENCE BY HAMBLETON IN 1972.
- FOUND 2 1/2" X 30" ALUMINUM PIPE WITH 2 1/2" ALUMINUM CAP ATTACHED SET FROM EXISTING EVIDENCE BY WELLS IN 1983.
- SET 2 1/2" X 30" G.I. PIPE WITH 2 1/2" BRASS CAP ATTACHED BY TRAVERSE SURVEY.
- APPROXIMATE 1/16th LINES.

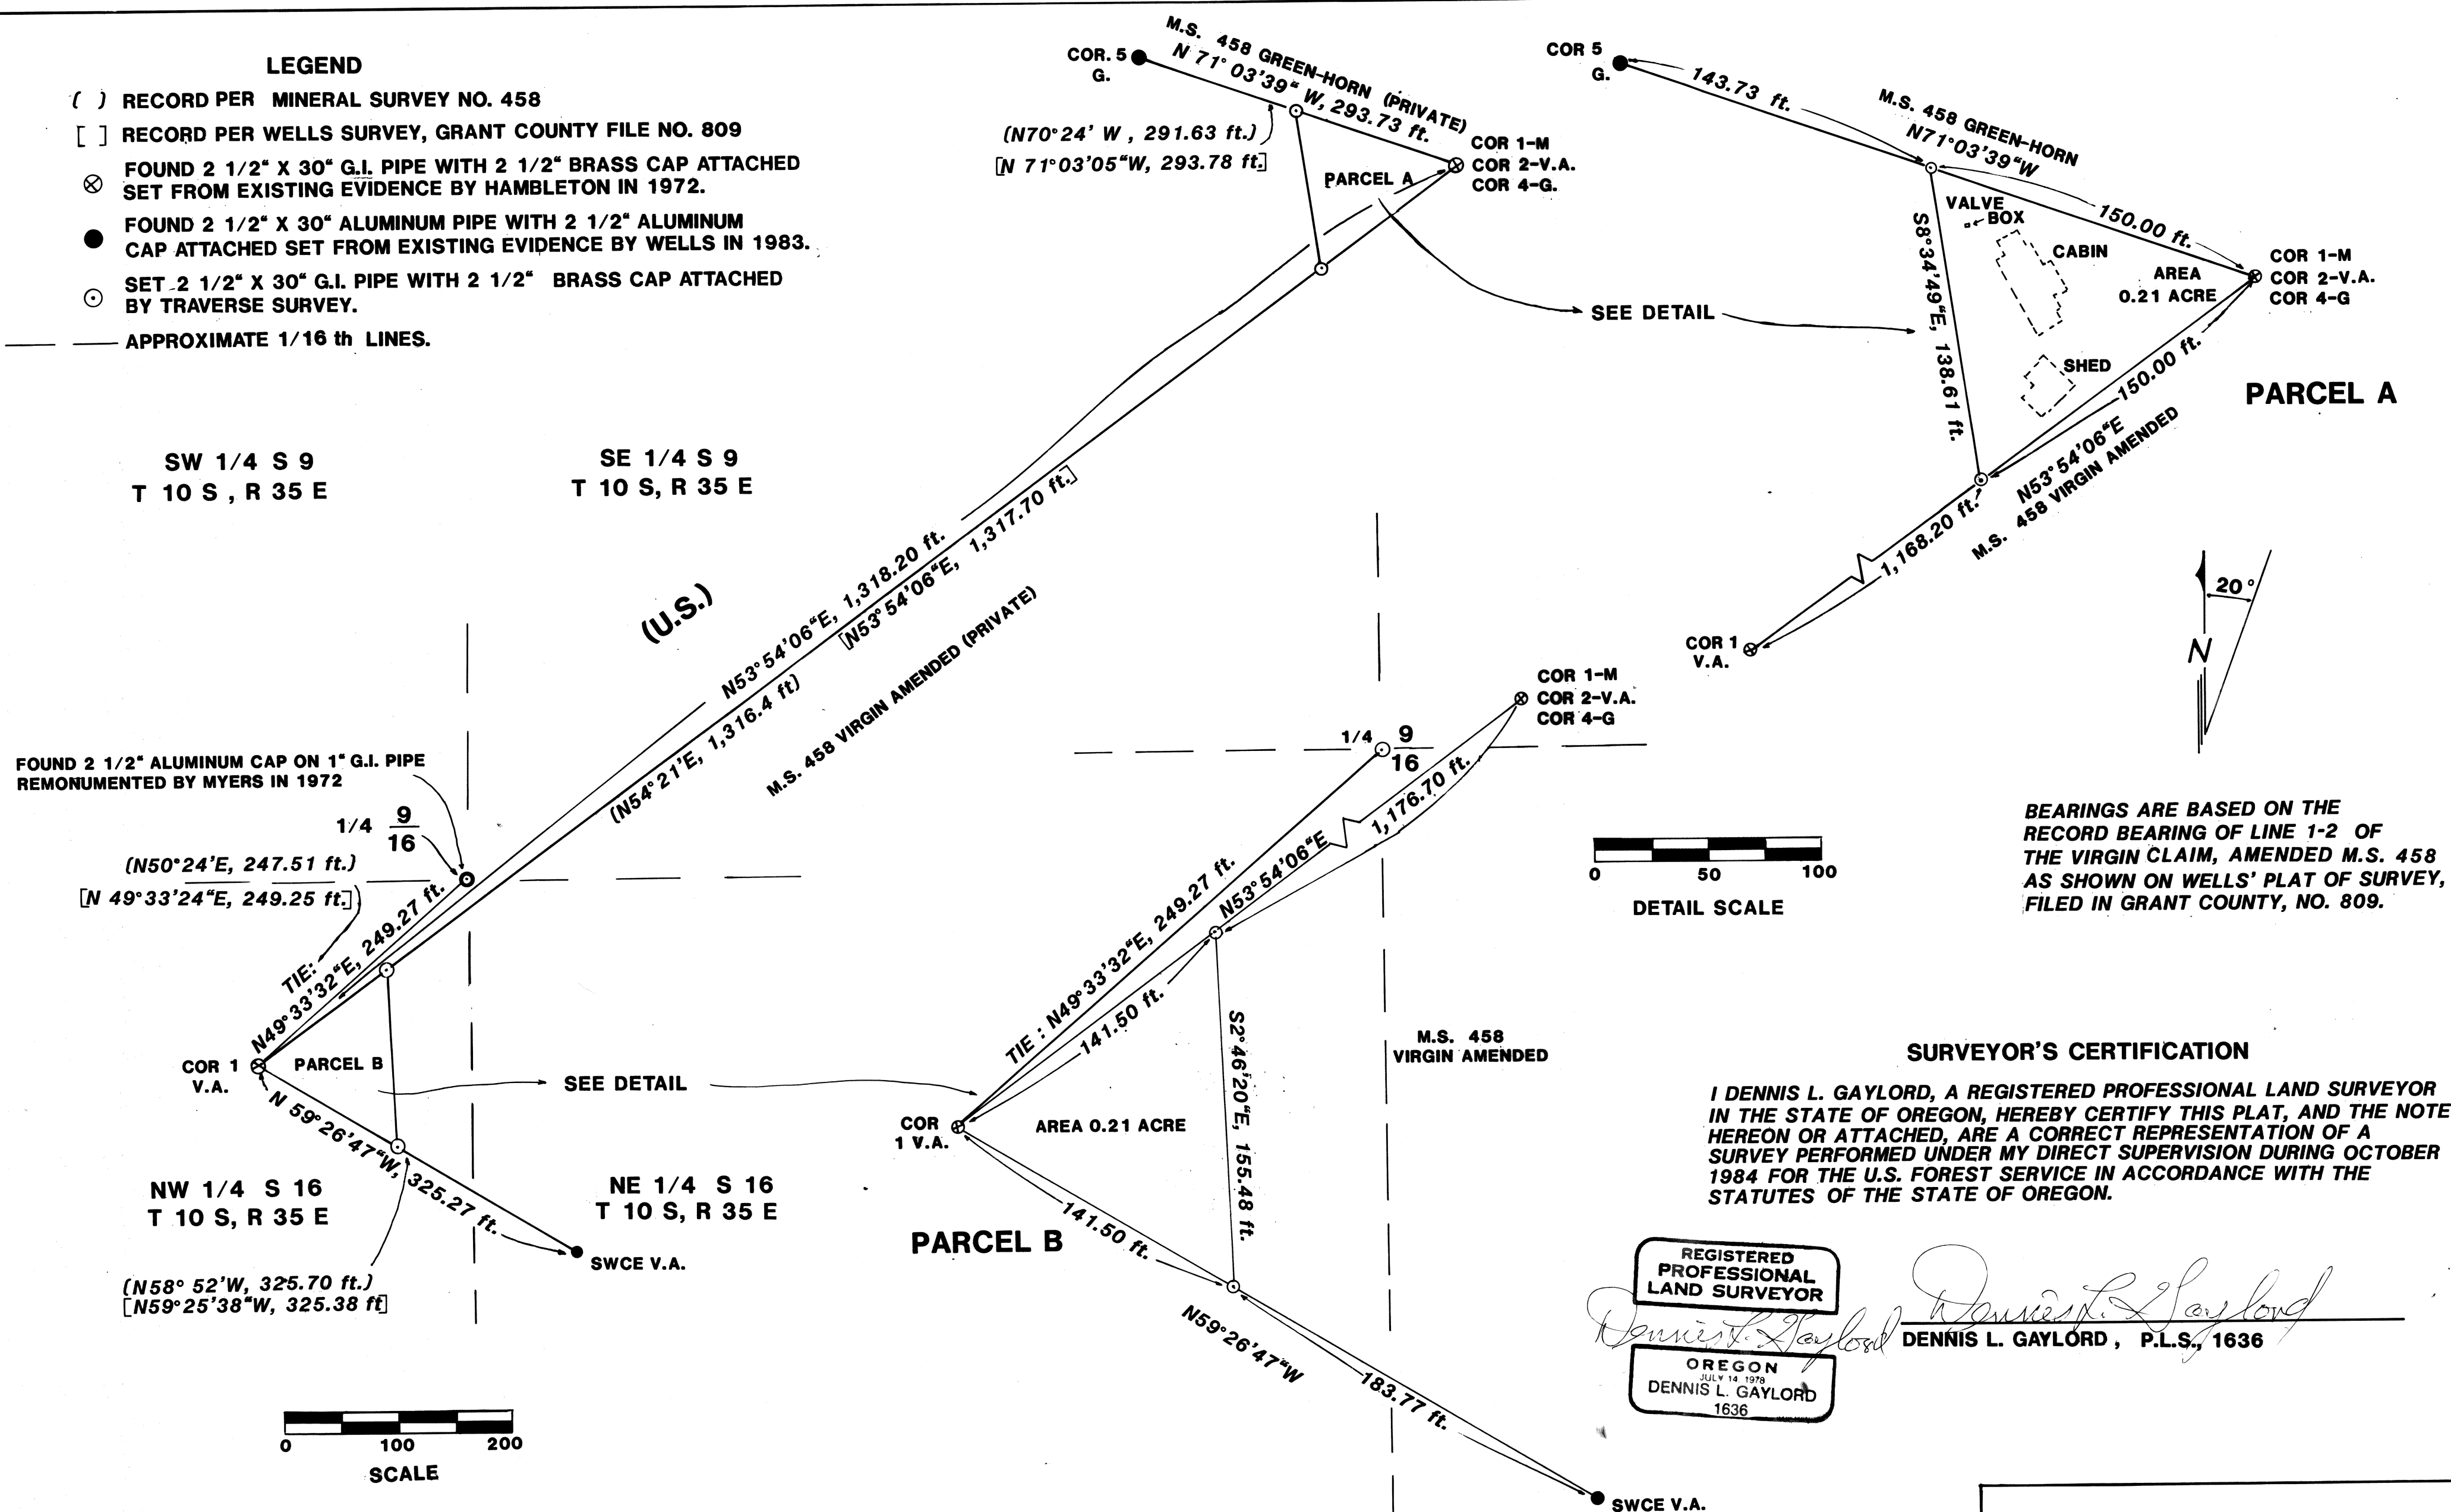

BEARINGS ARE BASED ON THE RECORD BEARING OF LINE 1-2 OF THE VIRGIN CLAIM, AMENDED M.S. 458 AS SHOWN ON WELLS' PLAT OF SURVEY, FILED IN GRANT COUNTY, NO. 809.

SURVEYOR'S CERTIFICATION

I DENNIS L. GAYLORD, A REGISTERED PROFESSIONAL LAND SURVEYOR IN THE STATE OF OREGON, HEREBY CERTIFY THIS PLAT, AND THE NOTES HEREON OR ATTACHED, ARE A CORRECT REPRESENTATION OF A SURVEY PERFORMED UNDER MY DIRECT SUPERVISION DURING OCTOBER 1984 FOR THE U.S. FOREST SERVICE IN ACCORDANCE WITH THE STATUTES OF THE STATE OF OREGON.

REGISTERED
PROFESSIONAL
LAND SURVEYOR

OREGON
JULY 14, 1978
DENNIS L. GAYLORD
1636

DENNIS L. GAYLORD, P.L.S., 1636

HISTORY OF SURVEYS

THE 1/4 CORNER COMMON TO SECTIONS 9 AND 16 WAS ORIGINALLY ESTABLISHED BY HERMAN D. GRADON IN OCTOBER 1881.

MINERAL SURVEY NO. 458 WAS ORIGINALLY SURVEYED BY ARTHUR PHILBRICK IN 1902.

IN 1904 M.S. 458, VIRGIN CLAIM, WAS AMENDED BY WILLIAM W. ELMER. MINERAL SURVEY NO. 458 WAS RETRACED BY WILLIAM R. WELLS, PLS 1106, IN 1983.

NARRATIVE OF SURVEY

THIS SURVEY WAS PERFORMED WITH A ZEISS TH-43 THEOLITE AND A K. & E. AUTORANGER EDM. PURPOSE OF THIS SURVEY IS TO CREATE PARCELS A AND B WITH THE INTENT TO EXCHANGE OWNERSHIP OF SAID PARCELS UNDER THE PROVISIONS OF THE SMALL TRACTS ACT OF JANUARY 12, 1983 (96 STAT. 2535; 16 U.S.C. 521C)

NOTE:

PARCEL A IS LOCATED ENTIRELY WITHIN THE WORLEY CLAIM, MINERAL SURVEY NO. 196.

PARCEL B IS LOCATED ENTIRELY WITHIN THE VIRGIN CLAIM, AMENDED MINERAL SURVEY NO. 458.

PLAT OF SURVEY
MINERAL SURVEY NO. 458

LOCATED IN

SECTIONS 9 & 16
T.10 S., R.35E, W.M.

U.S. DEPARTMENT OF AGRICULTURE
UMATILLA NATIONAL FOREST
BAKER COUNTY, OREGON

DRAWN: *Charles R. Brund* DATE: 11-1-84

FILED Nov. 13, 1984

BAKER COUNTY SURVEYOR

SURVEY NO. 10-35-198