


CERTIFIED RECORD OF LAND CORNER MONUMENTATION

History of original corner establishment:

None

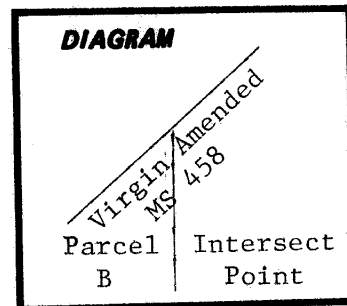

Description of corner evidence found:

None

Description of monument and accessories I established to perpetuate the

original location of this corner: At the intersect point of the east line of Parcel B and line 1-2 of Mineral Survey No. 458, Virgin Amended Lode, I set a 2½" x 30" galvanized iron pipe with a 3" brass cap attached 8" into the ground to bedrock. I build a mound of stones to the cap. Brass cap is marked:

T10S R35E

From which:

A 10" white fir bears N23°30'W, 60.8 ft.
scribed "X BT" on a single blaze.
A 7" lodgepole pine bears S43°E, 43.7
ft. scribed "X BT" on a single blaze.

IP VA
MS 458
PLS 1636
1984

I nailed a 3/4" brass washer, marked "PLS 1636",
flush on the lower portion of each bearing tree blaze.

Each bearing tree has a 54-3 and a 54-4 sign attached.

I hereby certify the above corner position was established as hereon described on
October 24, 1984. De: 20°East

Witnesses: Susan E. Newstetter and Cathy M. McGuire

**REGISTERED
PROFESSIONAL
LAND SURVEYOR**

Dennis L. Gaylord
**OREGON
JULY 14, 1978
DENNIS L. GAYLORD
1636**

Office of.....County Surveyor..... County of.....Baker.....
State of.....Oregon....., I hereby certify that the within instrument was filed in this office
for record on the..... day of....., 19.....
..... by
(COUNTY OFFICIAL) (DEPUTY)

Form R6-7100-57 (9/71)

FILED Nov. 13, 1984

BAKER COUNTY SURVEYOR

SURVEY NO. 10-35-199

GPO—798-276