


CERTIFIED RECORD OF LAND CORNER MONUMENTATION

History of original corner establishment:

None

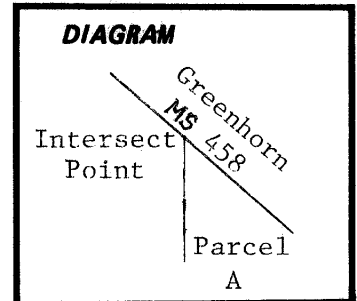

Description of corner evidence found:

None

Description of monument and accessories I established to perpetuate the

original location of this corner: At the intersect point of the west line of Parcel A and line 4-5 of Mineral Survey No. 458, Greenhorn Lode, I set a 2½" x 30" galvanized iron pipe with a 3" brass cap attached 22" into the ground in a mound of stone. Brass cap is marked:

T10S R35E

From which:

A 6" western larch bears S70°W, 13.9 ft.
scribed "X BT" on a single blaze.
A 7" lodgepole pine bears N44°30'W, 21.1
ft. scribed "X BT" on a single blaze.

G MS 458
IP



PLS 1636
1984

I nailed a 3/4" brass washer, marked "PLS 1636",
flush on the lower portion of each bearing tree blaze.

Each bearing tree has a 54-3 and a 54-4 sign attached.

I hereby certify the above corner position was established as hereon described on
October 24, 1984. De 20°East.

Witnesses: Susan E. Newstetter and Cathy M. McGuire

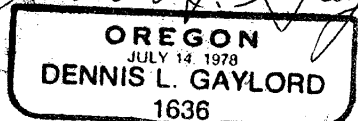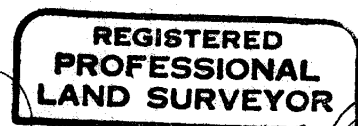

Office of... County Surveyor... County of... Baker

State of... Oregon... I hereby certify that the within instrument was filed in this office

for record on the... day of... , 19....

..... by
(COUNTY OFFICIAL) (DEPUTY)

Form R6-7100-57 (9/71)

FILED Nov. 13, 1984

BAKER COUNTY SURVEYOR

SURVEY NO. 10-35-201