


CERTIFIED RECORD OF LAND CORNER MONUMENTATION

History of original corner establishment:

None

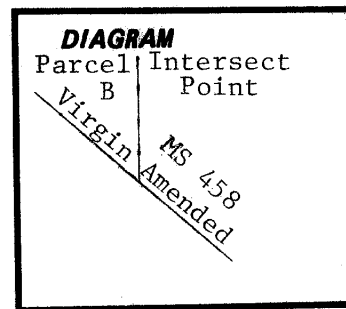


Description of corner evidence found:

None

Description of monument and accessories I established to perpetuate the

original location of this corner: At the intersect point of the east line of Parcel B and the line from corner 1 and the southwest center end of Mineral Survey No. 458, Virgin Amended Lode, I set a 2½" x 30" galvanized iron pipe with a 3" brass cap attached 15" into the ground in a mound of stones to the cap. Brass cap is marked:

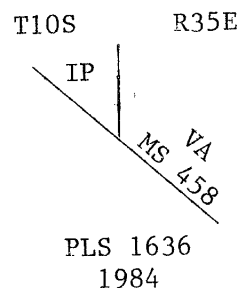

From which:


- A 9" lodgepole pine bears N5°E, 30.1 ft. scribed "X BT" on a single blaze.
- A 8" white fir bears N56°30'E, 7.4 ft. scribed "X BT" on a single blaze.

I nailed a 3/4" brass washer, marked "PLS 1636", flush on the lower portion of each bearing tree blaze.

Each bearing tree has a 54-3 and a 54-4 sign attached.

I hereby certify the above corner position was established as hereon described on October 24, 1984. De: 20°East

Witnesses: Susan E. Newstetter and Cathy M. McGuire

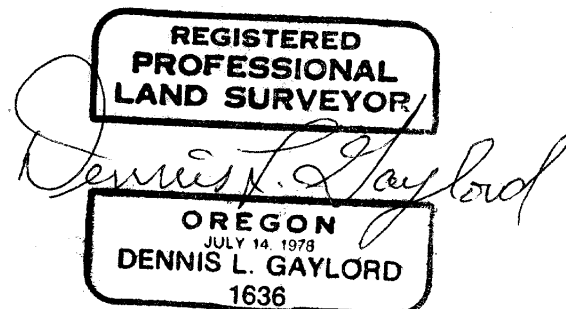

Office of.....County Surveyor.....County of.....Baker.....
State of.....Oregon....., I hereby certify that the within instrument was filed in this office
for record on the.....day of....., 19.....
.....by.....
(COUNTY OFFICIAL) (DEPUTY)

Form R6-7100-57 (9/71)

FILED Nov. 13, 1984
BAKER COUNTY SURVEYOR
SURVEY NO. 10-35-202