


CERTIFIED RECORD OF LAND CORNER MONUMENTATION

History of original corner establishment:

The corner was originally established by August W. Mohr under Mineral Survey No. 555 during June and July, 1904. The original notes state that at the corner a 4" square by 3' long pine post was set 18" in the ground and surrounded with a mound of earth. The post was marked "3-555-Danae". From the corner post:

A 40" pine bears N63 $\frac{1}{2}$ °E - 43' marked 3-555-D-BT.
A 24" pine bears N58°10'W - 58' marked 3-555-D-BT.
A 30" pine bears S60°W - 14' marked 3-555-Danae BT.

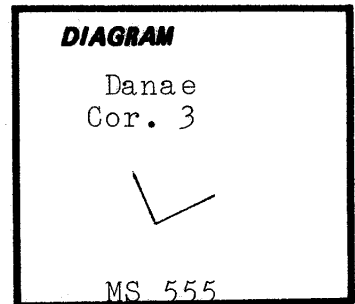

The corner was remonumented by James Hambleton in 1973, and a certified corner record was prepared and recorded.

Description of corner evidence found:

Found Hambleton's 2 $\frac{1}{2}$ " brass cap on a 2 $\frac{1}{2}$ " flanged g.i.p., protruding 15" from a mound of stone. A 40" ponderosa pine tree has fallen over about 3' East of the monument. From the monument:

A 36" dead, standing ponderosa pine bears N53°W-48.0' with visible scribing on an open blaze. (Original bearing tree).
A 36" dead, standing ponderosa pine bears S77°W-16.6' with visible scribing on an open blaze. (Original bearing tree).
A 40" down ponderosa pine bears N63 $\frac{1}{2}$ °E-43' to root hole with visible scribing on an open blaze. (Original bearing tree).

The bearings and distances from Hambleton's monument to the original bearing trees do not match the record well. Hambleton does not state whether he found the original corner. Monument appears to be in the proper position based on the down NE bearing tree and the distance to the SW bearing tree.

Description of monument and accessories | established to perpetuate the original location of this corner:

We maintained Hambleton's monument by placing more stones around it. Marked two new bearing trees:

A 8" white fir bears S52°E-18.5' scribed 3-D-555 BT.
A 18" white fir bears N85°W-23.1' scribed 3-D-555 BT.
Each new bearing tree has a brass washer stamped PLS 1106 nailed to the face of the blaze. Attached signs 54-3 and 54-9 to each bearing tree and painted face of blaze and a 6" red band around each bearing tree.


Set steel fence posts on National Forest Boundary NE and NW of corner and attached 54-2 signs to both posts and 54-9 sign to one post.

Used steel tape and staff compass with 20°E declination, measured to the center of the bearing trees.


This corner was maintained on June 18, 1985.

Cap is marked:

Witness: John Tuttle

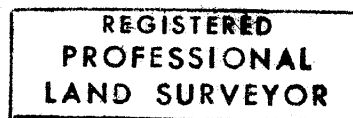

William R. Wells

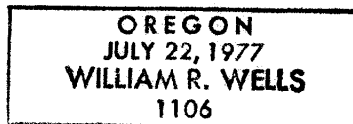

Danae No. 3
MS 555

3
1973
645

Office of... County Surveyor..... County of... Baker.....
State of... Oregon....., I hereby certify that the within instrument was filed in this office
for record on the... 5... day of... July....., 19... 85
..... by
(COUNTY OFFICIAL) (DEPUTY)