


CERTIFIED RECORD OF LAND CORNER MONUMENTATION

History of original corner establishment:

The corner was originally established by August W. Mohr under Mineral Survey No. 555 during June and July, 1904. The original notes state that at the corner a 5" square marked fir post, 3' long, was set 18" in the ground and surrounded with a mound of earth from which:

A 24" fir bears N43°18'W-45.1'.
A 24" fir bears S53°39'W-37.5'.
Both scribed 9-555 B.T. HF.

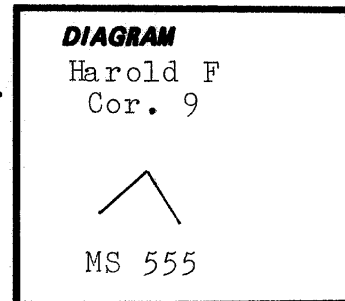

The corner was remonumented by James Hambleton in 1973, and a certified corner record was prepared and recorded.

Description of corner evidence found:

Hambleton's 2½" brass cap on a 2½" flanged g.i.p. protruding 16" from a mound of stone from which:

A 34" dead douglas fir bears S 53½°W-38.1' with scribing visible on an open blaze. (Original bearing tree).
A 30' high, 20" diameter, dead fir snag bears N45°W-45.8' with visible scribing on an opened blaze. (Original bearing tree).
A 10" dead and down ponderosa pine bears S30½°W-22.1' with scribing visible on a partly healed blaze. (Hambleton bearing tree).
A 12" dead ponderosa pine bears N80½°W-15.5' with scribing visible on a partly healed blaze. (Hambleton bearing tree).

Description of monument and accessories established to perpetuate the original location of this corner:

Maintained Hambleton's monument by placing more stones around it. Marked two new bearing trees:


A 15" western larch bears S78½°W-21.1' scribed 9-HF-555 BT.
A 19" douglas fir bears N13½°E-20.8' scribed 9-HF-555 BT.
Each new bearing tree has a brass washer stamped PLS 1106 nailed to the face of the blaze. Attached sign 54-3 and 54-9 to each bearing tree and painted face of blaze and a 6" red band around each bearing tree.

Set steel fence posts on National Forest Boundary SW and SE of corner and attached sign 54-2 to both posts and sign 54-9 to one post.


Used steel tape and staff compass with 20°E declination, measured to the center of the bearing trees.

This corner was maintained on June 18, 1985.

Witness: John Tuttle.

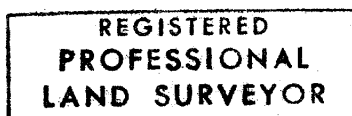

William R. Wells

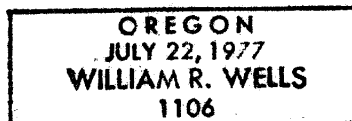

Cap is marked:

Harold F
MS 555

9
1973
645

Office of...County...Surveyor..... County of...Baker.....
State of...Oregon....., I hereby certify that the within instrument was filed in this office
for record on the...5... day of...July....., 19..85

..... by
(COUNTY OFFICIAL) (DEPUTY)