


LEGEND

- () RECORD PER MINERAL SURVEY NO. 458
- [] RECORD PER WELLS SURVEY, GRANT COUNTY FILE NO. 809.
- ⊗ FOUND 2 1/2" X 30" G.I. PIPE WITH 2 1/2" BRASS CAP ATTACHED SET FROM EXISTING EVIDENCE BY HAMBLETON IN 1972.
- FOUND 2 1/2" X 30" ALUMINUM PIPE WITH 2 1/2" ALUMINUM CAP ATTACHED SET FROM EXISTING EVIDENCE BY WELLS IN 1983.
- ① SET 2 1/2" X 30" G.I. PIPE WITH 2 1/2" BRASS CAP ATTACHED.
- ⊙ SET 2 1/2" X 30" ALUMINUM PIPE WITH 3" ALUMINUM CAP ATTACHED AT INTERSECT POINT.
- SET 5/8" IRON ROD WITH 1 1/2" ALUMINUM CAP ATTACHED FROM ORIGINAL EVIDENCE.
- PROJECTED LINES.
- ////// LINE POSTED.

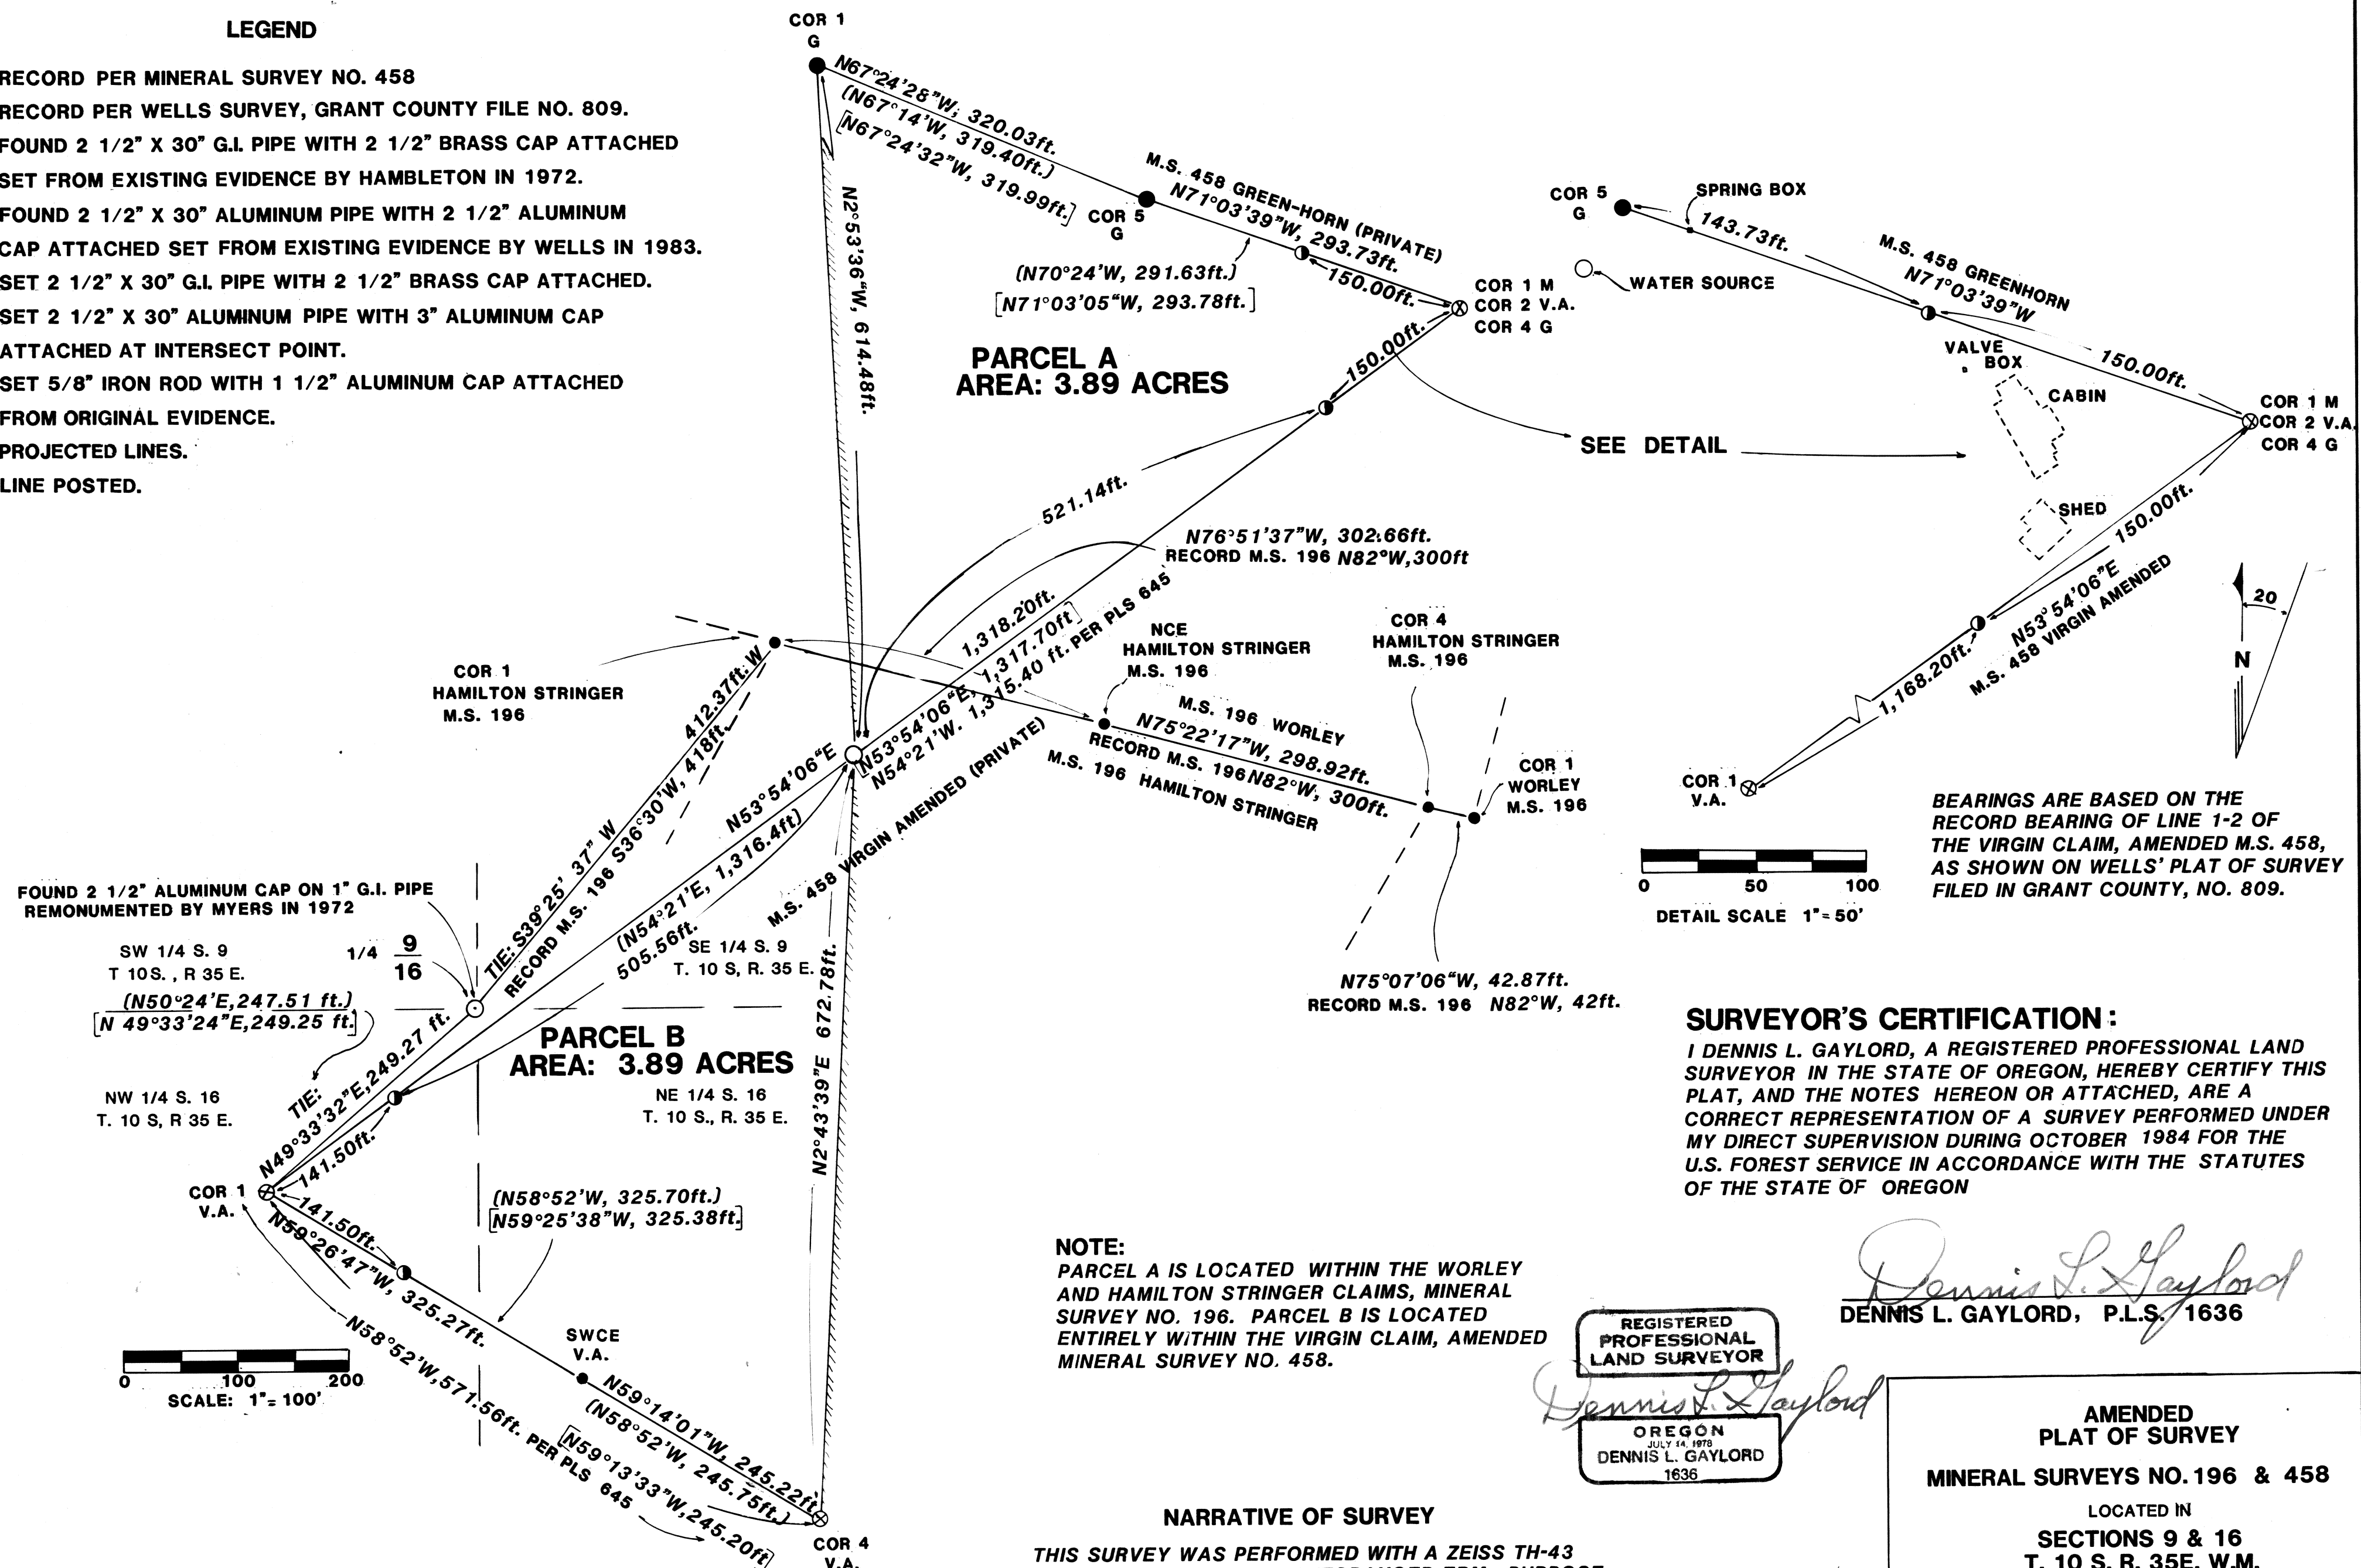

SURVEYOR'S CERTIFICATION:

I DENNIS L. GAYLORD, A REGISTERED PROFESSIONAL LAND SURVEYOR IN THE STATE OF OREGON, HEREBY CERTIFY THIS PLAT, AND THE NOTES HEREON OR ATTACHED, ARE A CORRECT REPRESENTATION OF A SURVEY PERFORMED UNDER MY DIRECT SUPERVISION DURING OCTOBER 1984 FOR THE U.S. FOREST SERVICE IN ACCORDANCE WITH THE STATUTES OF THE STATE OF OREGON

Dennis L. Gaylord
DENNIS L. GAYLORD, P.L.S. 1636

REGISTERED
PROFESSIONAL
LAND SURVEYOR

OREGON
JULY 14, 1975
DENNIS L. GAYLORD
1636

NOTE:

PARCEL A IS LOCATED WITHIN THE WORLEY AND HAMILTON STRINGER CLAIMS, MINERAL SURVEY NO. 196. PARCEL B IS LOCATED ENTIRELY WITHIN THE VIRGIN CLAIM, AMENDED MINERAL SURVEY NO. 458.

NARRATIVE OF SURVEY

THIS SURVEY WAS PERFORMED WITH A ZEISS TH-43 THEODOLITE AND A K&E AUTORANGER EDM. PURPOSE OF THIS SURVEY IS TO CREATE PARCELS A AND B WITH THE INTENT TO EXCHANGE OWNERSHIP OF SAID PARCELS UNDER THE PROVISIONS OF THE SMALL TRACTS ACT OF JANUARY 12, 1983 (96 STAT. 2535, 16 U.S.C. 521C). FOR DESCRIPTIONS OF CORNERS MONUMENTED, SEE CERTIFIED RECORD OF LAND CORNER MONUMENTATION FORMS FILED HERewith.

FILED Sept. 24, 1985
BAKER COUNTY SURVEYOR
SURVEY NO. 10-35-207

HISTORY OF SURVEYS

THE 1/4 CORNER COMMON TO SECTIONS 9 AND 16 WAS ORIGINALLY ESTABLISHED BY HERMAN D. GRADON IN OCTOBER 1881. MINERAL SURVEY NO. 196 WAS ORIGINALLY SURVEYED BY CHARLES M. FOSTER IN MAY 1889. MINERAL SURVEY NO 458 WAS ORIGINALLY SURVEYED BY ARTHUR PHILBRICK IN 1902. IN 1904 M.S. 458, VIRGIN CLAIM, WAS AMENDED BY WILLIAM W. ELMER. A PORTION OF M.S. 458 WAS RETRACED BY JAMES H. HAMBLETON, PLS 645, IN 1974. MINERAL SURVEY NO 458 WAS RETRACED BY WILLIAM R. WELLS, PLS 1106, IN 1983.

AMENDED
PLAT OF SURVEY
MINERAL SURVEYS NO. 196 & 458
LOCATED IN
SECTIONS 9 & 16
T. 10 S, R. 35E, W.M.
U.S. DEPARTMENT OF AGRICULTURE
UMATILLA NATIONAL FOREST
BAKER COUNTY, OREGON

DRAWN: *Curtis R. Brock* DATE: 9/19/85