


CERTIFIED RECORD OF LAND CORNER MONUMENTATION

History of original corner establishment:

The original corner was established by Charles M. Foster on May 3, 1889:

Set a post marked "S No 1" with a mound of stone around it.

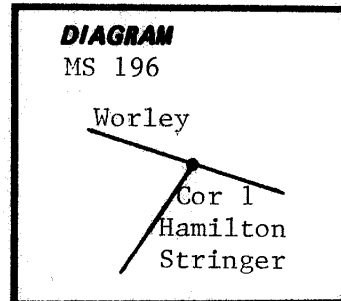

Description of corner evidence found: Mound of Stones - No trace of the original post was found.

Description of monument and accessories I established to perpetuate the

original location of this corner: In the center of the original mound of stones I set a 5/8" x 24" Iron Rod 12" into the ground with a 1 1/2" aluminum cap attached. I raised the stone mound higher, to the cap. The aluminum cap is marked:

From Which:

A 23" fir bears S64°E, 67.7 feet, scribed "X 1 HS MS 196 BT" on a single blaze.


A 27" fir bears N20°W, 51.8 feet, scribed "X 1 HS MS 196 BT" on a single blaze.

Both bearing trees have 54-3 and 54-4 signs attached, and a 3/4" brass washer, marked "PLS 1636", nailed flush on the lower portion of the blaze. De: 20°E. Measurements made to the center of the trees.

I hereby certify the above corner position was perpetuated as hereon described on August 6, 1985.

Witness: Steven J. Scritchfield

USDA - FS
MS 196 W

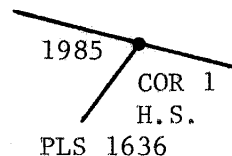

**REGISTERED
PROFESSIONAL
LAND SURVEYOR**

OREGON
JULY 14, 1978
DENNIS L. GAYLORD
1636

Office of..County..Surveyor..... County of...Baker.....
State of...Oregon....., I hereby certify that the within instrument was filed in this office
for record on the...24... day of...Sept....., 19.85

..... by
(COUNTY OFFICIAL) (DEPUTY)

Form R6-7100-57 (9/71)

GPO—798-276

FILED _____

BAKER COUNTY SURVEYOR

SURVEY NO. 10-35-210