


CERTIFIED RECORD OF LAND CORNER MONUMENTATION

History of original corner establishment:

None

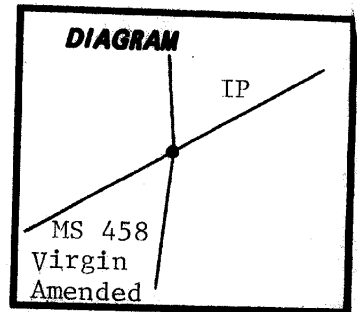

Description of corner evidence found:

None

Description of monument and accessories I established to perpetuate the

original location of this corner: At the point of Intersection of parcels A and B with line 1-2 of the Virgin Lode, Mineral Survey No. 458, amended, I set a 2½" x 30" Aluminum pipe with a 3" aluminum cap attached with a mound of stones around the pipe to the cap. The cap is marked:

U.S. Dept. of Agri. - Forest Service

From Which:

A 7" fir bears N60°W, 31.6 feet, scribed "X BT" on a single blaze.




A 11" fir bears S5°W, 30.3 feet, scribed "X BT" on a single blaze.

A decayed wood post in a mound of stones, origin unknown, bears N85°W, 4.2 feet.

Both bearing trees have 54-3 and 54-9 signs attached and a 3/4" brass washer, marked "PLS 1636", nailed flush on the lower portion of the blaze. De: 20°E. Measurements made to center of tree.

I hereby certify the above position was established and monumented as hereon described on August 6, 1985.

Witness: Steven J. Scritchfield

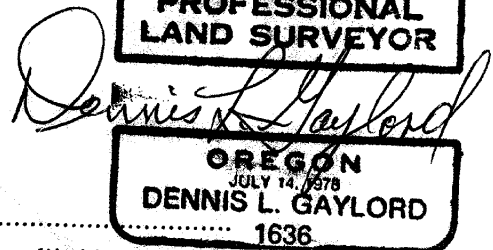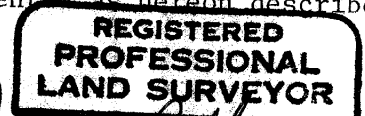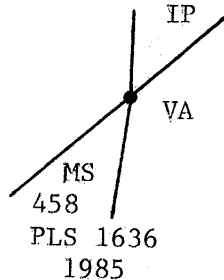

Office of... County Surveyor..... County of... Baker

State of... Oregon....., I hereby certify that the within instrument was filed in this office for record on the... 24... day of... Sept....., 1985

..... by
(COUNTY OFFICIAL) (DEPUTY)

Form R6-7100-57 (9/71)

GPO—798-276

FILED
BAKER COUNTY SURVEYOR
SURVEY NO. 10-35-212