


CERTIFIED RECORD OF LAND CORNER MONUMENTATION

L-25

History of original corner establishment:

This corner was originally established by Herman D. Graddon, U.S Deputy Surveyor, under his Contract No. 416, dated August 19, 1881, during September, 1881. The original notes state that at the corner a 16" by 6" by 6" marked basalt stone was set 11" in the ground from which:

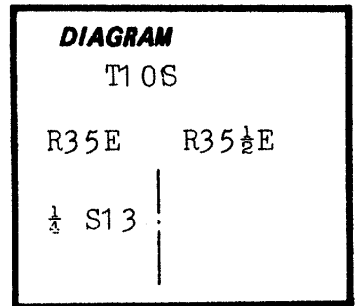

A 24" pine bears S65°E-76 lks, marked 1/4S BT.
A 16" pine bears N65°W-64 lks, marked 1/4S BT.

In July, 1882, under his Contract No. 398, Eugene P. McCornack, U.S. Deputy Surveyor, changed this corner to refer to Section 13 only. The original monument and accessories were used by McCornack.

Records indicate that Myers' remonumented this corner in 1967.

Description of corner evidence found:

A 28" pon. pine bears N63°W-42.2' with scribing visible on a partly healed blaze.
A 24" rotted, sawn, pine stump bears S63°E-50.2' with no scribing.

The corner was reestablished on line between the remains of the 2 bearing trees at the record distance. Myers' monument was not found-- probably destroyed by logging.

Description of monument and accessories | established to perpetuate the original location of this corner:

Set a 2½" by 30" aluminum pipe with 2½" aluminum cap 24" in the ground and surrounded with a mound of earth and stone from which:

A 14" white fir bears S36½°W-23.9' scribed 1/4 S13 BT.

New bearing tree has a brass washer stamped PLS 1106 nailed to the face of blaze. Attached sign 54-3 and 54-9 and painted face of blaze and a 6" red band around each bearing tree. Set steel fence post North of corner and attached sign 54-9.

Used steel tape and staff compass with 20°E declination, measured to the center of the bearing trees.


Cap is marked:

This corner was remonumented on October 24, 1985.

Witness: Willard Hulick.

T10 S

R35E	R35½E
¼ S13	
1985 PLS 1106	

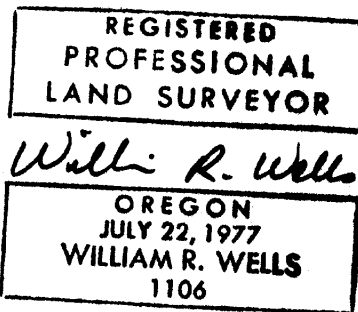

Office of...County Surveyor.....County of...Baker.....
State of...Oregon....., I hereby certify that the within instrument was filed in this office
for record on the.....day of....., 19.....
.....by.....
(COUNTY OFFICIAL) (DEPUTY)

6-36-7100-57 (9/71)

☆ GPO—798-276

FILED 2-3-86
BAKER COUNTY SURVEYOR
SURVEY NO. 10-35-214

FILED 2-3-86
BAKER COUNTY SURVEYOR
SURVEY NO. 10-35½-92