


CERTIFIED RECORD OF LAND CORNER MONUMENTATION

History of original corner establishment:

This corner was originally established by Leland Myers in 1968. See Map No. 10S-35 $\frac{1}{2}$ -53, and corner certificate.

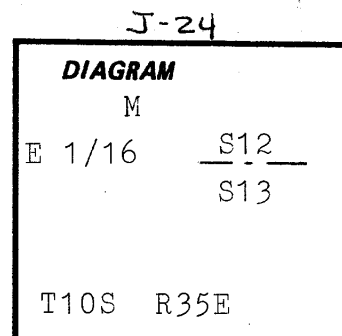

Description of corner evidence found:

Found Myers 2" brass cap on 1" flanged GIP protruding 12" from the ground. Myers monument and corner position was accepted as located.

REGISTERED
PROFESSIONAL
LAND SURVEYOR

Will R. Wells

OREGON
JULY 22, 1977
WILLIAM R. WELLS
1106

Description of monument and accessories | established to perpetuate the original location of this corner:

Maintained Myers monument by piling stones and earth around it. From the monument:

A 8" Western Larch bears N 23 $\frac{1}{2}$ ⁰ W - 55.0', scribed: E 1/16 S12 BT.

A 9" Western Larch bears S 24 $\frac{1}{2}$ ⁰ W - 43.2', scribed: E 1/16 S13 BT.

New bearing trees have a brass washer stamped PLS 1106 nailed to face of blaze. Attached signs 54-3 and 54-9, and painted face of blaze and a 6" red band around each bearing tree.

Set steel fence posts on National Forest Boundary South and East of corner and attached sign 54-9 to one post, and sign 54-2 to both posts.

Used steel tape and staff compass with 19⁰E declination, measured to the center of the bearing trees.

This corner was maintained on July 3, 1986.

Witnessed by: Willard Hulick.

Cap is marked:
M

E 1/16 $\frac{S12}{S13}$

1968
ORLS 699

Office of.....County Surveyor.....County of.....Baker.....
State of.....Oregon....., I hereby certify that the within instrument was filed in this office
for record on the..... day of....., 19.....
..... by
(COUNTY OFFICIAL) (DEPUTY)