


CERTIFIED RECORD OF LAND CORNER MONUMENTATION

K-24

History of original corner establishment:

This corner was originally established by Leland Myers in 1968. See Map No. 10S-35½E-53, and corner certificate.

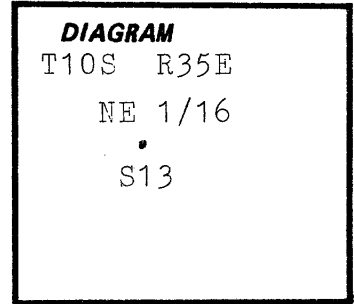

Description of corner evidence found:

Found a 2" brass cap on 1" flanged G.I.P. by Myers, protruding 12" from a stone mound. Bears S 37° 40' E - 14.3' from the corner position determined on this survey.

REGISTERED
PROFESSIONAL
LAND SURVEYOR

William R. Wells

OREGON
JULY 22, 1977
WILLIAM R. WELLS
1106

Description of monument and accessories I established to perpetuate the original location of this corner:

Set a 2½" by 30" aluminum pipe with 2½" aluminum cap 20" in the ground and surrounded with a mound of earth and stone, from which:

A 17" Ponderosa Pine bears S 80° E - 47.4', scribed: NE 1/16 S13 BT.

A 11" Ponderosa Pine bears N 2¼° W - 69.2', scribed: NE 1/16 S13 BT.

New bearing trees have a brass washer stamped PLS 1106 nailed to face of blaze. Attached signs 54-3 and 54-9, and painted face of blaze and a 6" red band around each bearing tree.

Set steel fence posts on National Forest Boundary North and East of the corner, and attached sign 54-9 to one post and sign 54-2 to both posts.

Used steel tape and staff compass with 19°E declination, measured to the center of the bearing trees.

This corner was remonumented on July 8, 1986.

Witnessed by: Willard Hulick.

Cap is marked:

T10S R35E

NE 1/16

•
S13

1986

PLS 1106

Office of.....County Surveyor.....County of.....Baker.....
State of.....Oregon....., I hereby certify that the within instrument was filed in this office
for record on the..... day of....., 19.....
..... by
(COUNTY OFFICIAL) (DEPUTY)