


CERTIFIED RECORD OF LAND CORNER MONUMENTATION

History of original corner establishment:


This corner was originally established by Leland Myers in 1968. See Map No. 10S-35 $\frac{1}{2}$ E-53, and corner certificate.

K-25

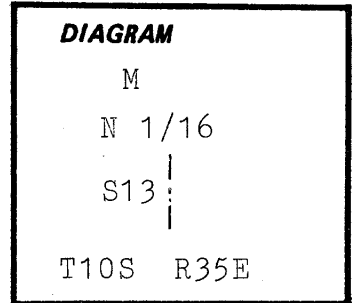

Description of corner evidence found:

Found Myers' 2" brass cap, marked as shown, on a 1" flanged G.I.P. protruding 12" from the ground.

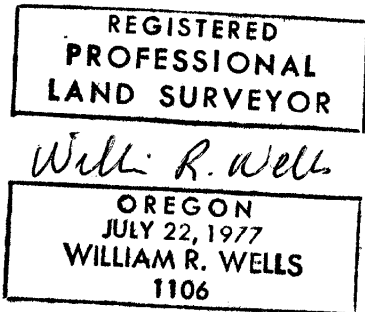

Description of monument and accessories | established to perpetuate the original location of this corner:

Maintained Myers monument by piling stones around it. From the monument:

A 10" White Fir bears S 74 $\frac{1}{2}$ <sup>0</sup> W - 23.4', scribed: N 1/16 S13 BT.

A 15" White Fir bears N 36 $\frac{1}{2}$ <sup>0</sup> W - 50.1', scribed: N 1/16 S13 BT.

New bearing trees have a brass washer stamped PLS 1106 nailed to face of blaze. Attached signs 54-3 and 54-9, and painted face of blaze and a 6" red band around each bearing tree.

Set steel fence posts on National Forest Boundary North and West of the corner, and attached sign 54-9 to one post and sign 54-2 to both posts.

Used steel tape and staff compass with 20<sup>0</sup>E declination, measured to the center of the bearing trees.

This corner was maintained on July 9, 1986.

Cap is marked:

Witnessed by: Willard Hulick.

M  
N 1/16  
S13  
1968  
ORLS 699

Office of.....County Surveyor.....County of.....Baker.....  
State of.....Oregon....., I hereby certify that the within instrument was filed in this office  
for record on the.....day of....., 19.....  
.....by.....  
(COUNTY OFFICIAL) (DEPUTY)