


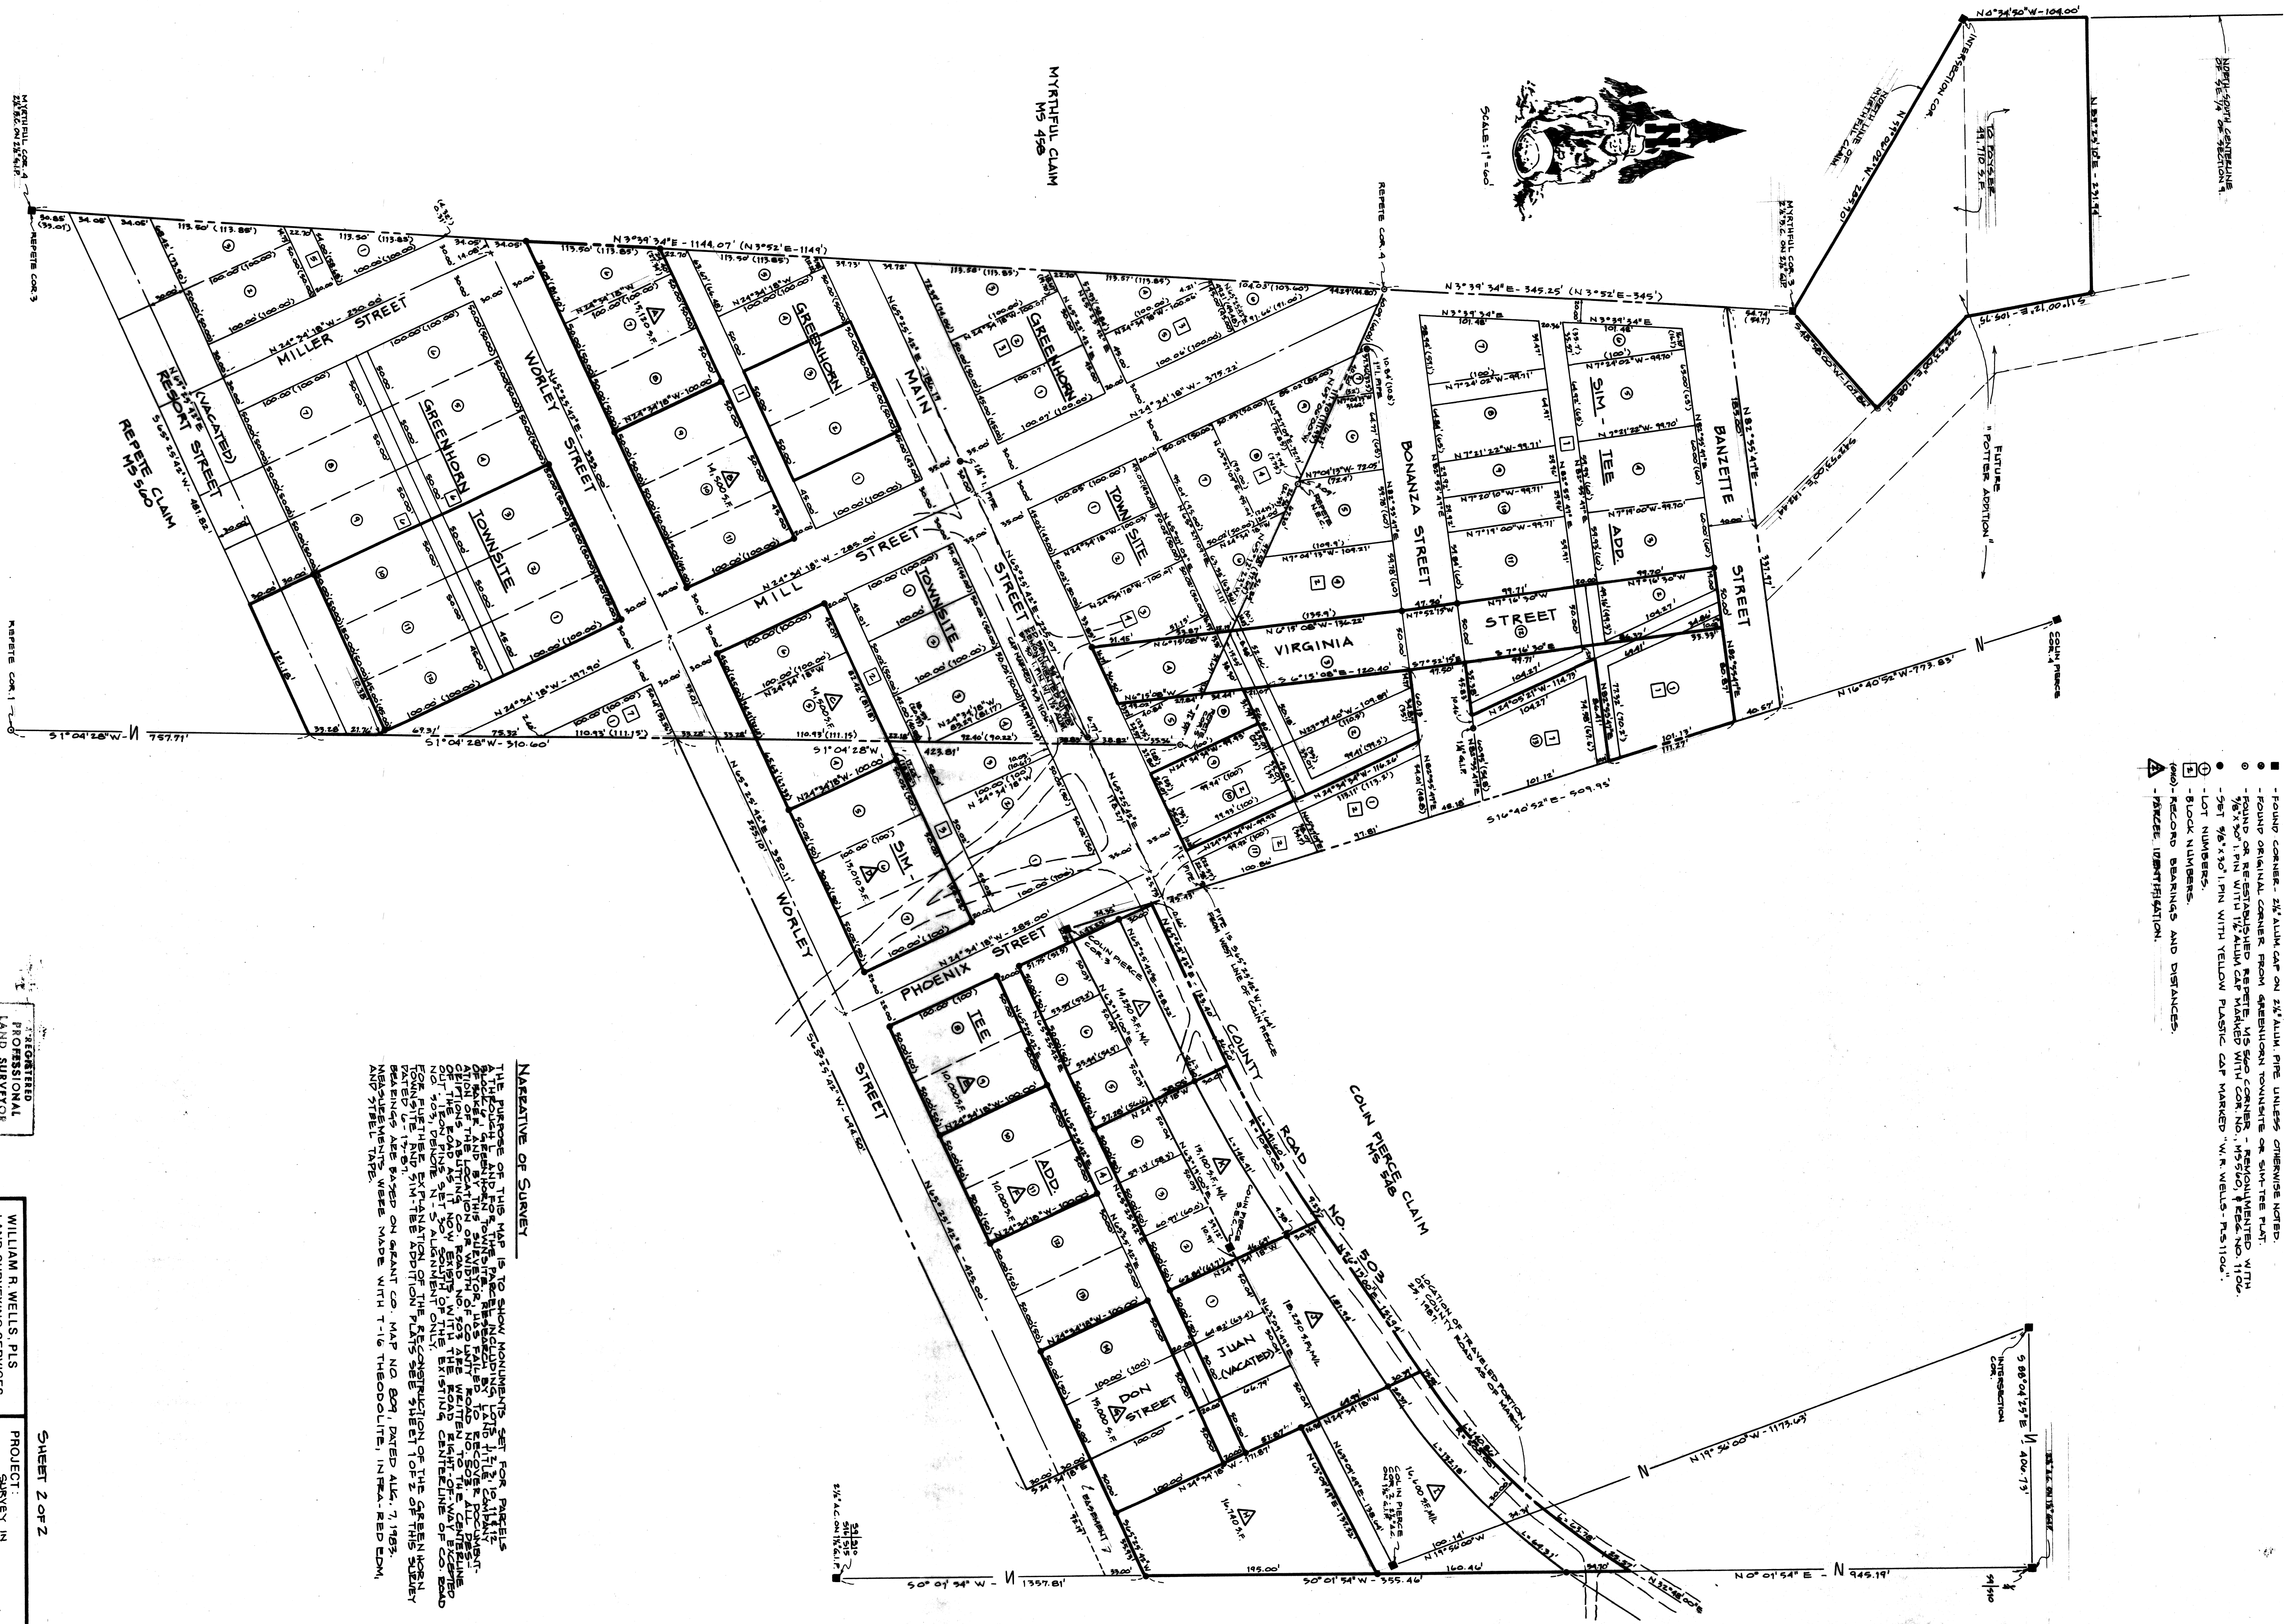

LEGEND

- - FOUND CORNER - 2 1/2" ALUM CAP ON 3/4" ALUM PIPE UNLESS OTHERWISE NOTED.
- - FOUND ORIGINAL CORNER FROM SKEWELION TOWNSHIRE OR SURVIVE PLAT.
- - FOUND OR RE-ESTABLISHED RESERVE 1/2" AND CORNER - RE-LOCATED WITH 3/4" X 3/4" PIN WITH 1/2" ALUM CAP MARKED WITH "R.S. 1104".
- - 3/4" X 3/4" PIN WITH YELLOW PLASTIC CAP MARKED "W.R. WELLS 75-1104".
- ① - LOT NUMBERS.
- ② - BLOCK NUMBERS.
- ③ - RECORD BEARINGS AND DISTANCES.
- ④ - PLOTCE IDENTIFICATION.

NARRATIVE OF SURVEY

[illegible]

FILED 7-15-87
BANKER COUNTY SUPERVISOR - 1106
SURREINER NO. 10-35-2265
WILLIAM R. WELLS
JULY 22, 1977
WILLIAM R. WELLS
1106
RECREATED
PROFESSIONAL
LAND SURVEYOR

Date: 4-19-87 CK. By: _____	Dr. By: _____ No. 4-10