


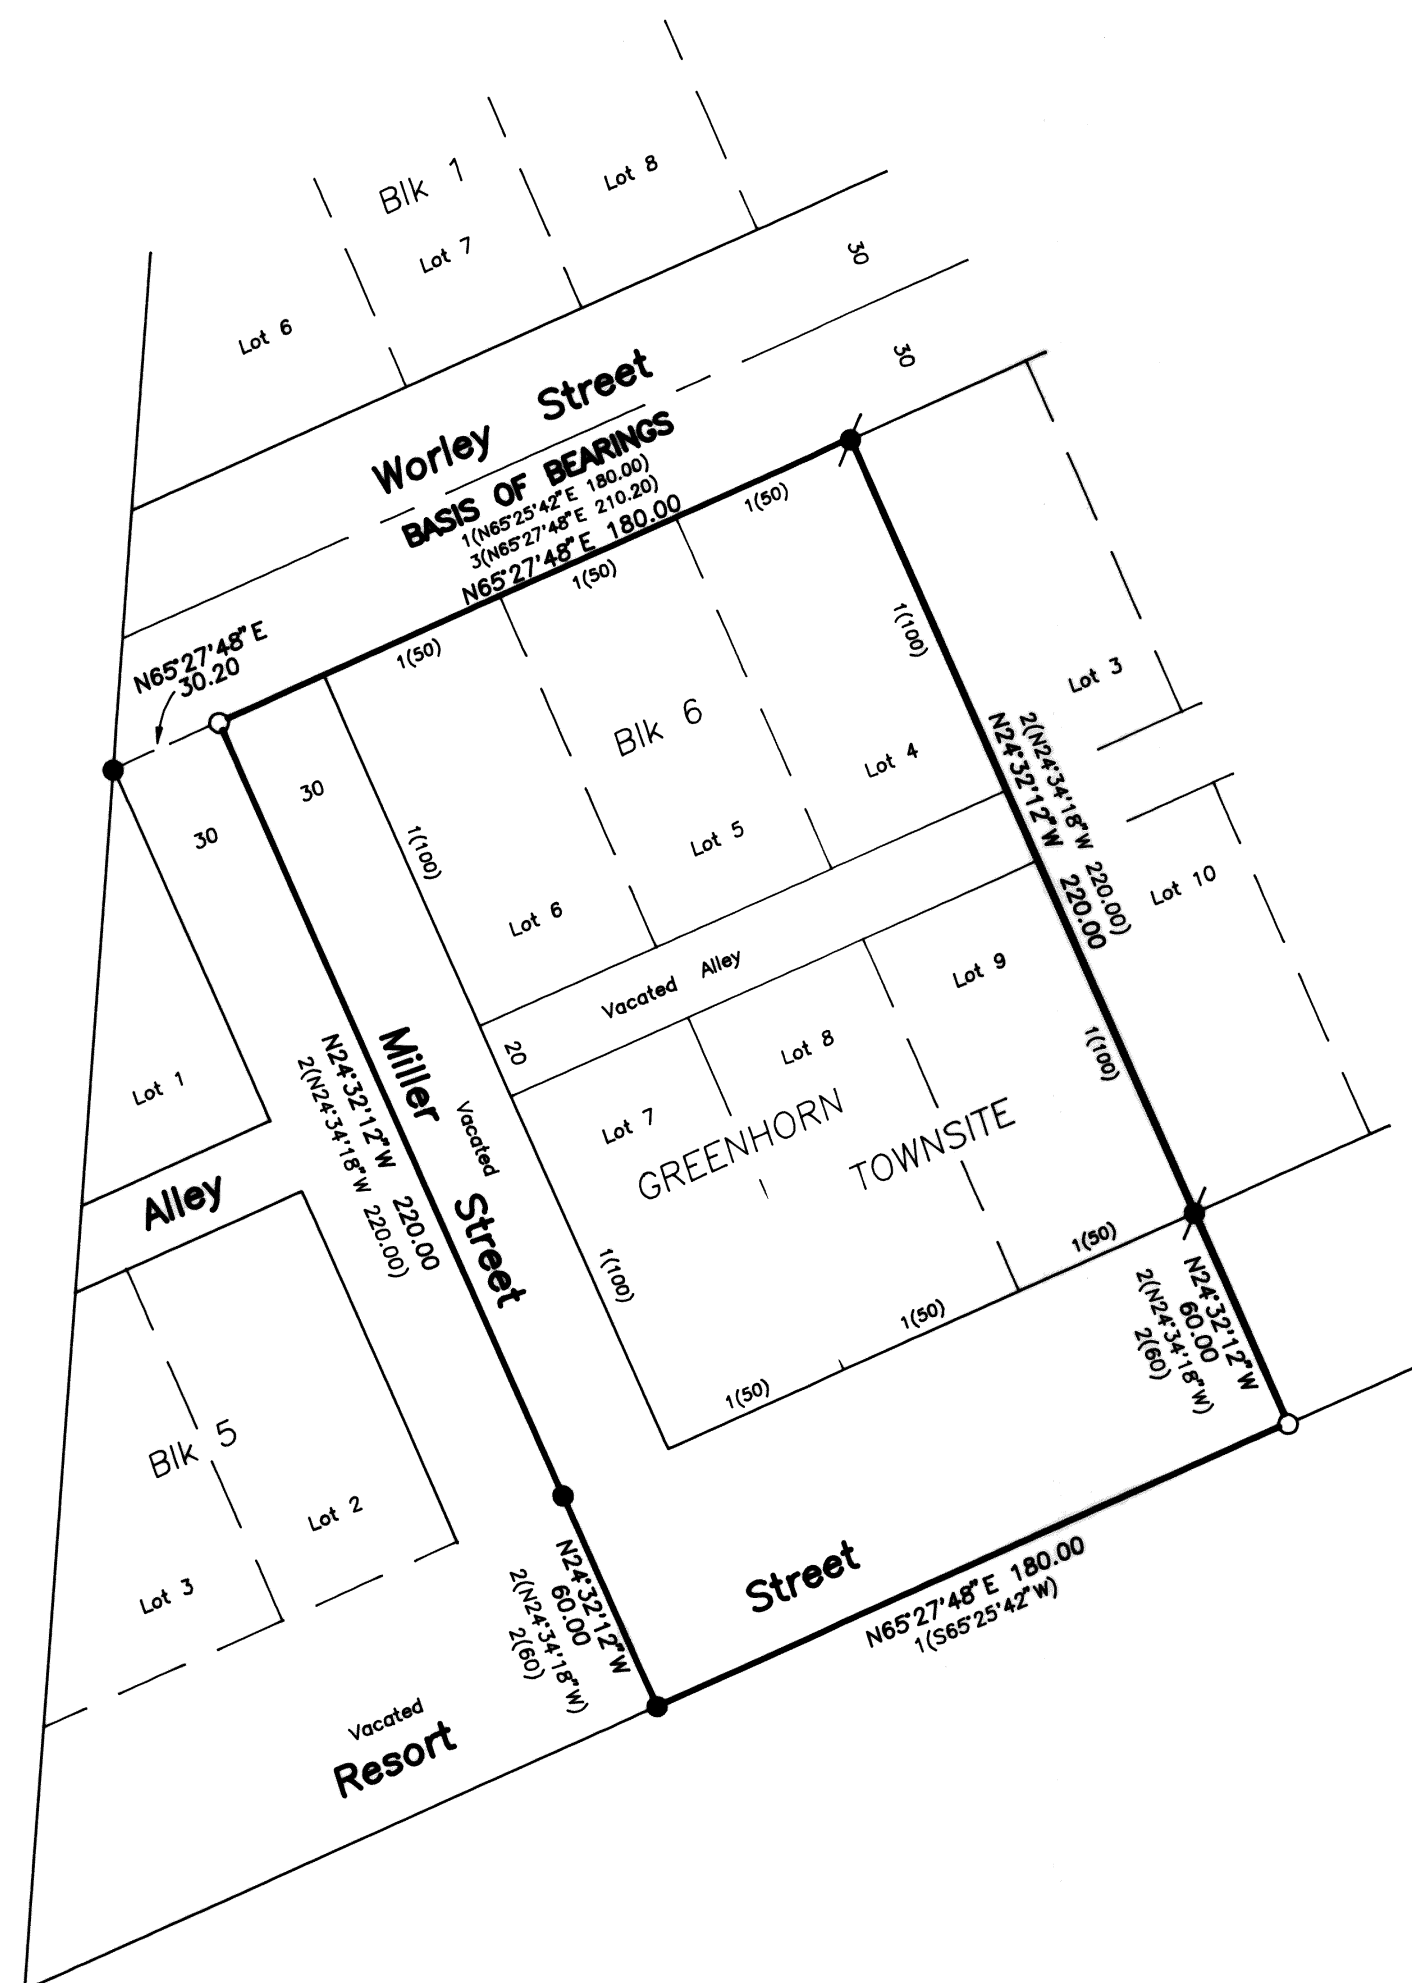

Scale 1"=50'

BASIS OF BEARINGS

Survey No. 10-35-226

LEGEND

- Found 5/8" iron pin with attached yellow plastic cap, See Survey No. 10-35-225
- Found 5/8" iron pin with attached red plastic cap, See Survey No. 10-35-226.
- Set 5/8"x30" iron pin with attached red plastic cap marked CORNERSTONE SURVEYING, INC.
- 1() Greenhorn Townsite record bearing and distance.
- 2() Survey No. 10-35-225 record bearing and distance.
- 3() Survey No. 10-35-226 record bearing and distance.

NARRATIVE

This survey was performed at the request of Jeff Cooper. The purpose of this survey was to locate the boundaries of Mr. Cooper's property.

A search was made of the available records pertaining to this survey and field measurements were made to locate the monuments from Survey No. 10-35-225 on the easterly line of Lots 4 and 9. Several monuments from Survey No. 10-35-226 were also located. The monuments on the easterly boundary were accepted and the SE corner of Mr. Cooper's property was established on the line extended to the southerly side line of Resort Street, which has been vacated. I accepted the monuments shown to position Worley Street and Miller Street. The NW corner of Mr. Cooper's property was set on the southerly side line of Worley Street and on the center line of Miller Street, which has been vacated.

FILED JUNE 24, 2003
BAKER COUNTY SURVEYOR
SURVEY NO. 10-35-227

REGISTERED
PROFESSIONAL
LAND SURVEYOR
Jack Watson
OREGON
SEPT. 19, 1995
JACK L. WATSON
2734
Renewal Date 6/30/2004

CORNERSTONE SURVEYING, Inc.
233 S. Canyon Blvd., John Day, Oregon 97845
(541) 575-1813

MAP OF SURVEY
LOTS 4 THRU 9, BLOCK 6
GREENHORN TOWNSITE
SE1/4 SECTION 9, T10S, R35E, W.M.
BAKER COUNTY, OREGON

SURVEYED FOR: **JEFF COOPER**
SURVEYED BY : Jack Watson Date: June 17, 2003
DRAWN BY : Jack Watson