

CERTIFIED RECORD OF LAND CORNER MONUMENTATION


History of original corner establishment:

Original corner set by Arthur D. Zierold, under Mineral Survey No. 998,
approved September 27, 1985.
record states:

Set an iron post, 30 ins. long, 2 $\frac{3}{8}$ ins. diam., 16 ins. in concrete and rock in a hole
excavated in hard rock, and in a mound of stone, with 2 $\frac{1}{2}$ ins. diam. brass cap
mkd. RAINBOW AM. COR. NO. 4 MS 998 ADZ 1985

from which:

A Douglas fir, 30 ins. diam., bears N. 26° E., 15.8 ft. dist., mkd. RB-4-998 BT X.
A Douglas fir, 15 ins. diam., bears S. 52° W., 47.3 ft. dist., mkd. RB-4-998 BT X.

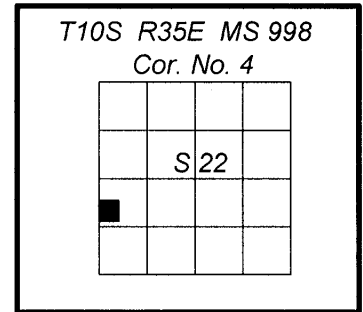

Description of corner evidence found:

Found a 2 $\frac{3}{8}$ ins. diam. iron post with a 2 $\frac{1}{2}$ ins. diam. brass cap, mkd. as shown, projecting 18 ins. above ground,
firmly set, with 3' diam. stone mound.

Recovered bearing trees:

A ponderosa pine, 32 ins. diam., alive & healthy, bears N. 26° E., 15.8 ft. dist., with visible scribe on open blaze.
A fir snag, 18 ins. diam., bears S. 52° W., 47.3 ft. dist., with visible scribe on open blaze.

Found steel T-post 3 ft. South of recovered monument.

**Description of monument and accessories I established to
perpetuate original location of this corner:**

New bearing tree

A juniper, 11 ins. diam., bears S. 11° W., 32.7 ft. dist., mkd. X BT, on double blaze, with washer in face.


NAD 83 CORS '96 geographic position:

Lat. 44°41'11.9" N
Long. 118°29'39.5" W

All bearing trees are painted with red bands, and have Bearing Tree (54-3) and Land Survey
Monument (54-9) signs attached.

Posted National Forest Boundary N. 41°05'26" E. and S. 54°31'22" E. from corner with Property Boundary
(54-2) signs, and a Land Survey Monument (54-9) sign on nearby post.

Witnesses: Matt Brockamp and Dustin Palmer
Date: July 10, 2009

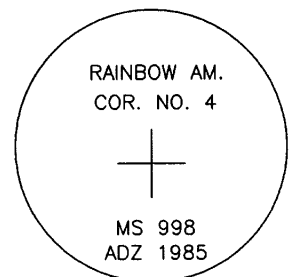

REGISTERED
PROFESSIONAL
LAND SURVEYOR

Ron Walter

OREGON
JANUARY 18, 1994
RON C. WALTER
2648

Renewal Date: June 30, 2010

Office of County Surveyor County of Baker
State of Oregon , I hereby certify that the within instrument was filed in this office
for record on the day of , 20
..... by
(COUNTY OFFICIAL) (DEPUTY)

FILED Feb. 24, 2010