

CERTIFIED RECORD OF LAND CORNER MONUMENTATION

History of original corner establishment:

Original corner set by August W. Mohr, under Mineral Survey No. 555,
approved April 12, 1905.
record states:
Set a rock in place 8 ft. x 6 ft. x 5 ft. with an X chiseled on the South end,


from which:

- A fir, 30 ins. diam., bears N. 65° E., 3.5 ft. dist., scribed 3-555 BT.
- A fir, 12 ins. diam., bears S. 65° E., 6.7 ft. dist., scribed 3-555 BT.
- A fir, 15 ins. diam., bears N. 45½° W., 28.6 ft. dist., scribed 3-555 BT.

Subsequent Monumentation:

Corner was remonumented by James H. Hambleton, LS 645, as described by
Corner Record 10-35-49, recorded November 30, 1973, in the records of the
Baker County Recorder.

No new bearing trees.

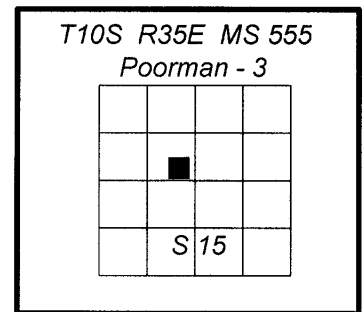


Description of corner evidence found:

Found a 2 ins. diam. iron post with a 2 ins. diam. brass cap, mkd. as shown, projecting 16 ins. above
ground, firmly set, in a 4' diam. stone mound.

From the recovered monument I find the original bearing trees :

- A fir, dead & down, bears N. 65° E., 6.7 ft. dist., with healed blaze. (3.5 ft. dist., Mohr)
- A fir snag, 24 ins. diam., bears N. 45½° W., 28.6 ft. dist., with visible scribe on open blaze.

Found guard post 2 ft. dist. south of recovered monument, bent south'ly.

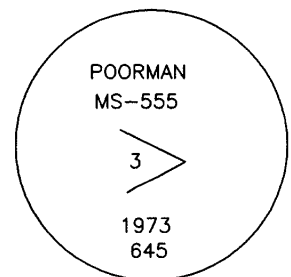

**Description of monument and accessories I established to
perpetuate original location of this corner:**

New bearing trees

- A fir, 7 ins. diam., bears S. 42° W., 34.5 ft. dist., mkd. X BT, on double blaze, with washer in face.
- A lodgepole pine, 10 ins. diam., bears N. 59° W., 25.9 ft. dist., mkd. X BT, on double blaze, with
washer in face.

Rebuild rock mound.

NAD 83 CORS '96 geographic position:


Lat. 44°41'57.7" N
Long. 118°29'12.6" W

All bearing trees are painted with red bands, and have Bearing Tree (54-3) and Land Survey
Monument (54-9) signs attached.


Posted National Forest Boundary S. 11°14'49" E. and S. 87°13'12" E. from corner with Property
Boundary (54-2) signs, and a Land Survey Monument (54-9) sign on nearby post.

Witnesses: Kristina Powell and Jake Smith

Date: July 10, 2009

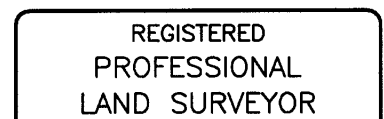

Ron Walter

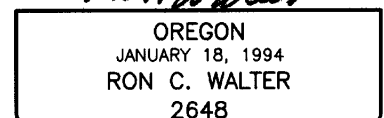

Renewal Date: June 30, 2010

Office of _____ County Surveyor _____ County of _____ Baker
State of _____ Oregon _____, I hereby certify that the within instrument was filed in this office
for record on the _____ day of _____, 20 ____
_____ by _____
(COUNTY OFFICIAL) (DEPUTY)

FILED Feb. 24, 2010