

CERTIFIED RECORD OF LAND CORNER MONUMENTATION

History of original corner establishment:

Original corner set by August W. Mohr, under Mineral Survey No. 555,
approved April 12, 1905.
record states:
Set a post 4 ins. sq., 3 ft. long, 18 ins. in the ground, scribed 3-555 Danae in a raised
mound of earth,

from which:

- A pine, 40 ins. diam., bears N. $63\frac{1}{2}^{\circ}$ E., 43.0 ft. dist., scribed 3-555-D-BT.
- A pine, 30 ins. diam., bears S. 60° W., 14.0 ft. dist., scribed 3-555-D-BT.
- A pine, 24 ins. diam., bears N. $58\frac{1}{4}^{\circ}$ W., 58.0 ft. dist., scribed 3-555-D-BT.

Subsequent Monumentation:


Corner remonumented by James H. Hambleton, LS 645, as described by Corner Record
10-35-42, recorded November 30, 1973, in the records of the Baker County Recorder.

No new bearing trees.

Corner perpetuated by William R. Wells, LS 1106, as described by Corner Record
10-35-203, recorded July 5, 1985, in the records of the Baker County Recorder.

from which:

- A white fir, 8 ins. diam., bears S. 52° E., 18.5 ft. dist., scribed 3-D-555 BT.
- A white fir, 18 ins. diam., bears N. 85° W., 23.1 ft. dist., scribed 3-D-555 BT.

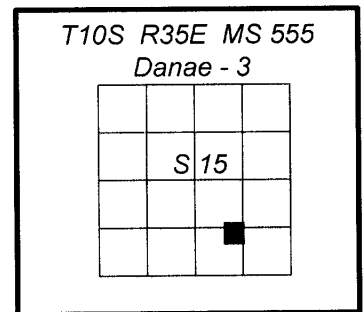

Description of corner evidence found:

Found a 2 ins. diam. iron post with a 2 ins. diam. brass cap, mkd. as shown, projecting 18 ins. above ground, firmly set,
in a 3' diam. stone mound.


from the recovered monument I find the original bearing trees

- A ponderosa pine, dead & down, bears N. $63\frac{1}{2}^{\circ}$ E., 43.0 ft. dist., with burned out face.
- A ponderosa pine, dead & down, bears S. 77° W., 16.6 ft. dist., with visible scribe on open blaze.
(S 60° W, 14.0', Mohr)

and the accessories mkd. by Wells

- A white fir, 11 ins. diam., alive & healthy, bears S. 52° E., 18.5 ft. dist., with healed blaze.
- A cut fir stump, 19 ins. diam., bears N. 85° W., 23.1 ft. dist., with healed blaze.

Found steel T-post 3 ft. North of monument with Land Survey Monument (54-9) sign.

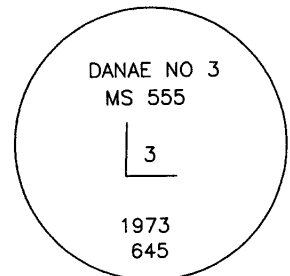

**Description of monument and accessories I established to
perpetuate original location of this corner:**

New bearing trees

- A white fir, 12 ins. diam., bears N. 51° E., 11.0 ft. dist., mkd. DC C3 MS 555 BT, with washer in face.
- A ponderosa pine, 26 ins. diam., bears N. 64° W., 86.3 ft. dist., mkd. X BT, on double blaze, with
washer in face.



NAD 83 CORS '96 geographic position:

Lat. $44^{\circ}41'39.2''$ N
Long. $118^{\circ}28'49.1''$ W

All bearing trees are painted with red bands, and have Bearing Tree (54-3) and Land Survey
Monument (54-9) signs attached.

Posted National Forest Boundary N. $15^{\circ}52'07''$ W. and N. $77^{\circ}01'42''$ E. from corner with Property
Boundary (54-2) signs, and a Land Survey Monument (54-9) sign on nearby post.

Witnesses: Matt Brockamp and Dustin Palmer
Date: July 9, 2009

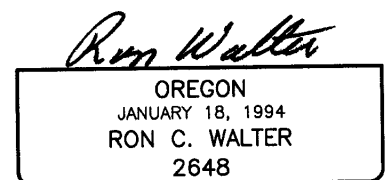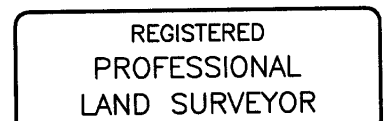

Renewal Date: June 30, 2010

Office of County Surveyor County of Baker
State of Oregon , I hereby certify that the within instrument was filed in this office
for record on the day of , 20
..... by
(COUNTY OFFICIAL) (DEPUTY)

FILED Feb. 24, 2010

Form R6-7100-57 (9/71)

BAKER COUNTY SURVEYOR

★GPO — 798-276

SURVEY NO. 10-35-236