

CERTIFIED RECORD OF LAND CORNER MONUMENTATION

History of original corner establishment:

Original corner set by August W. Mohr, under Mineral Survey No. 555,
approved April 12, 1905.
record states:
Set a fir post 6 ins. sq. 3 ft. long, set 18 ins. in ground, scribed 2-555 YJ,

from which:


- A pine, 34 ins. diam., bears N. 48° E., 37.0 ft. dist., scribed 2-555 YJ BT.
- A pine, 16 ins. diam., bears S. 20° E., 36.4 ft. dist., scribed 2-555 YJ BT.
- A pine, 18 ins. diam., bears S. 10¼° E., 54.0 ft. dist., scribed 2-555 YJ BT.

Subsequent Monumentation:

Corner remonumented by James H. Hambleton, LS 645, as described by Corner
Record 10-35-47, recorded November 30, 1973, in the records of the Baker
County Recorder.

from which

- A fir, 10 ins. diam., bears S. 20° E., 16.5 ft. dist., scribed YJ-2 MS555 BT, with
a brass tag stamped LS 645.
- A fir, 12 ins. diam., bears N. 54° W., 23.7 ft. dist., scribed YJ-2 MS555 BT, with
a brass tag stamped LS 645.

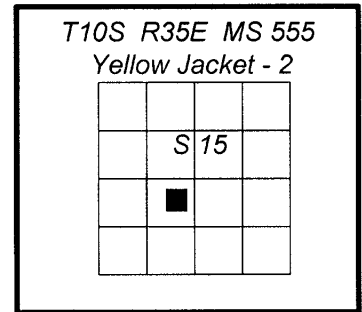

Description of corner evidence found:

Found a 2 ins. diam. iron post with a 2 ins. diam. brass cap, mkd. as shown, projecting 6 ins. above ground,
firmly set, with a rock collar.

from the recovered monument I find the original bearing trees

- A deteriorated pine stump, bears N. 48° E., 37.0 ft. dist., with pine remains.
- A stump hole, bears S. 18° E., 36.4 ft. dist., with pine remains. (S. 20° E., Mohr)
- A pine stump, bears S. 10¼° E., 54.0 ft. dist., with pine remains.
- and the accessories mkd. by Hambleton
- A fir, 17 ins. diam., alive & healthy, bears S. 20° E., 16.5 ft. dist., with healed blaze.
- A fir snag, 14 ins. diam., bears N. 54° W., 22.7 ft. dist., with visible scribe on open blaze. (23.7', Hambleton)

Found guard post 2 ft. west'ly, bent, with Land Survey Monument (54-9) sign.

**Description of monument and accessories I established to
perpetuate original location of this corner:**

New bearing tree

- A fir, 12 ins. diam., bears N. 80° E., 77.3 ft. dist., mkd. X BT, on double blaze, with washer in face.




NAD 83 CORS '96 geographic position:

- Lat. 44°41'52.6" N
- Long. 118°29'08.0" W

All bearing trees are painted with red bands, and have Bearing Tree (54-3) and Land Survey
Monument (54-9) signs attached.

Posted National Forest Boundary N. 78°55'43" W. and S. 15°53'02" W. from corner with Property
Boundary (54-2) signs, and a Land Survey Monument (54-9) sign on nearby post.

Witnesses: Kristina Powell and Jake Smith
Date: July 10, 2009

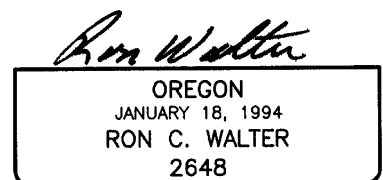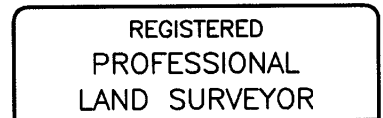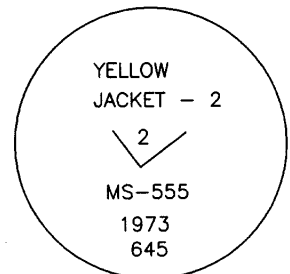

Renewal Date: June 30, 2010

Office of _____ County Surveyor _____ County of _____ Baker
State of _____ Oregon _____, I hereby certify that the within instrument was filed in this office
for record on the _____ day of _____, 20 ____
_____ by _____
(COUNTY OFFICIAL) (DEPUTY)

FILED Feb. 24, 2010
BAKER COUNTY SURVEYOR
SURVEY NO. 10-35-237