

CERTIFIED RECORD OF LAND CORNER MONUMENTATION

History of original corner establishment:


Original corner set by August W. Mohr, under Mineral Survey No. 555,
approved April 12, 1905.
record states:
Set a post 5 ins. sq., 3 ft. long, 18 ins. in the ground, scribed 4-5-555 in a raised mound of
earth,

from which:
A pine, 24 ins. diam., bears N. 45° E., 7.0 ft. dist., scribed 4-5-555 GEYJ BT.
A pine, 14 ins. diam., bears S. 50° W., 2.6 ft. dist., scribed 4-5-555 BT.
A pine, 14 ins. diam., bears N. 39° W., 21.0 ft. dist., scribed 4-5-555 BT.

Subsequent Monumentation:

Corner remonumented by James H. Hambleton, LS 645, as described by Corner Record
10-35-44, recorded November 30, 1973, in the records of the Baker County Recorder.

from which
A fir, 14 ins. diam., bears N. 5° E., 21.2 ft. dist., scribed GE-5 MS 555 BT, with a brass
tag stamped LS 645.
A fir, 22 ins. diam., bears East, 28.2 ft. dist., scribed GE-5 MS 555 BT, with a brass tag
stamped LS 645.

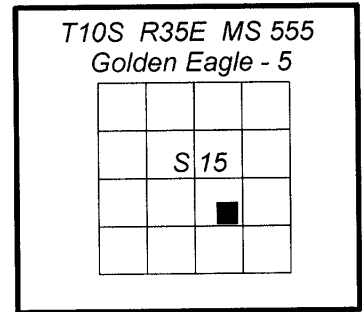


Description of corner evidence found:

Found a 2 ins. diam. iron post with a 2 ins. diam. brass cap, mkd. as shown, projecting 6 ins. above ground, firmly set,
with a rock collar.

from the recovered monument I find the original bearing trees
A deteriorated pine stump, bears N. 45° E., 7.0 ft. dist.
and accessories mkd. by Hambleton
A cut fir stump, bears N. 5° E., 21.2 ft. dist., with healed blaze.
A cut fir stump, bears East, 28.2 ft. dist., with axe mark.

Found steel T-post 3 ft. West of monument with Land Survey Monument (54-9) sign.

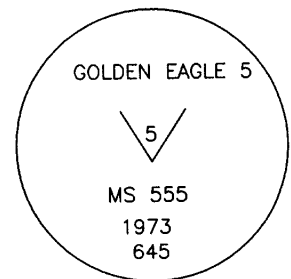

**Description of monument and accessories I established to
perpetuate original location of this corner:**

New bearing trees
A fir, 12 ins. diam., bears N. 48° E., 23.6 ft. dist., mkd. C5 GEC MS 555 BT, with washer in face.
A lodgepole pine, 7 ins. diam., bears N. 84° W., 21.8 ft. dist., mkd. X BT, on double blaze, with
washer in face.

NAD 83 CORS '96 geographic position:
Lat. 44°41'45.5" N
Long. 118°28'47.3" W

All bearing trees are painted with red bands, and have Bearing Tree (54-3) and Land Survey
Monument (54-9) signs attached.

Posted National Forest Boundary N. 84°05'28" W. and S. 74°06'16" W. from corner with Property
Boundary (54-2) signs, and a Land Survey Monument (54-9) sign on nearby post.

Witnesses: Kristina Powell and Jake Smith
Date: July 10, 2009

REGISTERED
PROFESSIONAL
LAND SURVEYOR

Ron C. Walter

OREGON
JANUARY 18, 1994
RON C. WALTER
2648

Renewal Date: June 30, 2010

Office of _____ County Surveyor _____ County of _____ Baker _____
State of _____ Oregon _____, I hereby certify that the within instrument was filed in this office
for record on the _____ day of _____, 20 _____.
_____ by _____
(COUNTY OFFICIAL) (DEPUTY)

FILED Feb. 24, 2010
BAKER COUNTY SURVEYOR
SURVEY NO. 10-35-238