

CERTIFIED RECORD OF LAND CORNER MONUMENTATION

History of original corner establishment:

Original corner set by August W. Mohr, under Mineral Survey No. 555, approved April 12, 1905.
record states:
Set a post 5 ins. sq., 3.5 ft. long, set 18 ins. in the ground with a raised stone mound of earth, scribed 3-555 HF

from which:


- A fir, 18 ins. diam., bears N. 75° E., 5.0 ft. dist., scribed 3-555 HF BT.
- A fir, 5 ins. diam., bears S. 86° W., 2.0 ft. dist., scribed 3-555 HF BT.

Subsequent Monumentation:

Corner remonumented by James H. Hambleton, LS 645, as described by Corner Record 10-35-38, recorded November 30, 1973, in the records of the Baker County Recorder.

from which

- A fir, 9 ins. diam., bears N. 36° W., 8.0 ft. dist., scribed Har. F-3-555 BT, with a brass tag stamped LS 645.

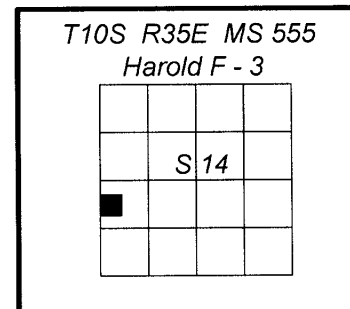


Description of corner evidence found:

Found a 2 ins. diam. iron post with a 2 ins. diam. brass cap, mkd. as shown, projecting 10 ins. above ground, firmly set, in a 3' diam. stone mound.

from the recovered monument I find the original bearing tree

- A fir, 34 ins. diam., alive & healthy, bears N. 75° E., 5.0 ft. dist., with healed blaze.
- and the accessories mkd. by Hambleton
- A fir snag, 13 ins. diam., bears N. 36° W., 8.0 ft. dist., with healed blaze.

Found steel T-post 3 ft. East of monument with Land Survey Monument (54-9) sign.

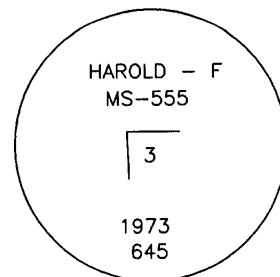

Description of monument and accessories I established to perpetuate original location of this corner:

New bearing tree

- A fir, 18 ins. diam., bears N. 6° E., 18.4 ft. dist., mkd. HF C3 MS555 X BT, with washer in face.

NAD 83 CORS '96 geographic position:

- Lat. 44°41'49.6" N
- Long. 118°28'26.4" W

All bearing trees are painted with red bands, and have Bearing Tree (54-3) and Land Survey Monument (54-9) signs attached.

Posted National Forest Boundary N. 74°09'42" E. and S. 19°04'43" E. from corner with Property Boundary (54-2) signs, and a Land Survey Monument (54-9) sign on nearby post.

Witnesses: Matt Brockamp and Dustin Palmer
Date: July 10, 2009

REGISTERED
PROFESSIONAL
LAND SURVEYOR

Ron C. Walter

OREGON
JANUARY 18, 1994
RON C. WALTER
2648

Renewal Date: June 30, 2010

Office of _____ County Surveyor _____ County of _____ Baker
State of _____ Oregon _____, I hereby certify that the within instrument was filed in this office
for record on the _____ day of _____, 20 ____
_____ by _____
(COUNTY OFFICIAL) (DEPUTY)

FILED Feb. 24, 2010
BAKER COUNTY SURVEYOR
SURVEY NO. 10-35-239