

CERTIFIED RECORD OF LAND CORNER MONUMENTATION

History of original corner establishment:


Original corner set by August W. Mohr, under Mineral Survey No. 555,
approved April 12, 1905.
record states:
Set a post 5 ins. sq., 3 ft. long, 18 ins. in the ground, scribed 10-555 HF, in a raised mound
of earth,

from which:
A fir, 28 ins. diam., bears N. 2½° E., 34.7 ft. dist., scribed 10-555HF BT.
A pine, 36 ins. diam., bears S. 11° E., 36.5 ft. dist., scribed 10-555 HF BT.

Subsequent Monumentation:

Corner remonumented by James H. Hambleton, LS 645, as described by Corner Record
10-35-33, recorded November 30, 1973, in the records of the Baker County Recorder.

from which
A red fir, 8 ins. diam., bears S. 75° E., 21.2 ft. dist., scribed Har. F-10 MS 555 BT, with a
brass tag stamped LS 645.

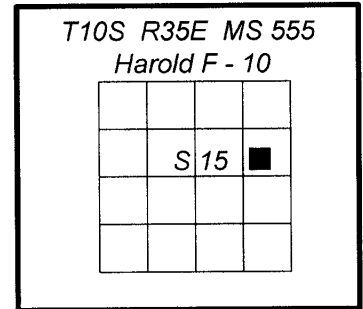


Description of corner evidence found:

Found a 2 ins. diam. iron post with a 2 ins. diam. brass cap, mkd. as shown, projecting 12 ins. above ground, firmly set,
in a 3' diam. stone mound.

from the recovered monument I find the original bearing trees
A fir snag, 38 ins. diam., bears N. 2½° E., 34.7 ft. dist., with visible scribe on open blaze.
A cut pine stump, bears S. 11° E., 36.5 ft. dist.
and the accessory mkd. by Hambleton
A white fir, 14 ins. diam., alive & healthy, bears S. 75° E., 21.2 ft. dist., with healed blaze.

Found steel T-post 3 ft. South-east'ly of monument with Land Survey Monument (54-9) sign.

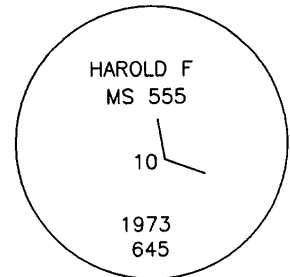

**Description of monument and accessories I established to
perpetuate original location of this corner:**


New bearing tree
A white fir, 16 ins. diam., bears N. 34½° E., 17.8 ft. dist., mkd. X BT, on double blaze, with washer
in face.

NAD 83 CORS '96 geographic position:
Lat. 44°41'58.7" N
Long. 118°28'35.2" W

All bearing trees are painted with red bands, and have Bearing Tree (54-3) and Land Survey
Monument (54-9) signs attached.

Posted National Forest Boundary N. 39°18'29" W. and S. 59°39'34" E. from corner with Property
Boundary (54-2) signs, and a Land Survey Monument (54-9) sign on nearby post.

Witnesses: Matt Brockamp and Dustin Palmer
Date: July 11, 2009

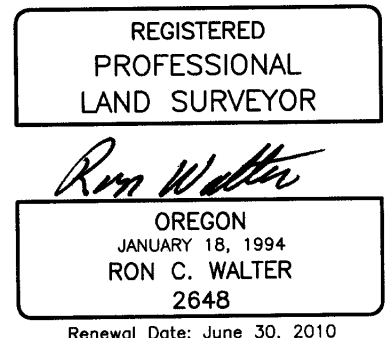

Office of _____ County Surveyor _____ County of _____ Baker
State of _____ Oregon _____, I hereby certify that the within instrument was filed in this office
for record on the _____ day of _____, 20 ____
_____ by _____
(COUNTY OFFICIAL) (DEPUTY)

FILED Feb. 24, 2010
BAKER COUNTY SURVEYOR
SURVEY NO. 10-35-240