

CERTIFIED RECORD OF LAND CORNER MONUMENTATION

History of original corner establishment:

Original corner set by August W. Mohr, under Mineral Survey No. 555,
approved April 12, 1905.
record states:
Set a post 6 ins. sq., 3 ft. long, set 18 ins. in the ground with raised mound of earth and
scribed 11-555 HF,


from which:

- A fir, 24 ins. diam., bears N. 78° E., 2.4 ft. dist., scribed 11-555 HF BT.
- A fir, 24 ins. diam., bears N. 87° W., 28.0 ft. dist., scribed 11-555 HF BT.

Subsequent Monumentation:

Corner remonumented by James H. Hambleton, LS 645, as described by Corner Record
10-35-34, recorded November 30, 1973, in the records of the Baker County Recorder.

No new bearing trees.

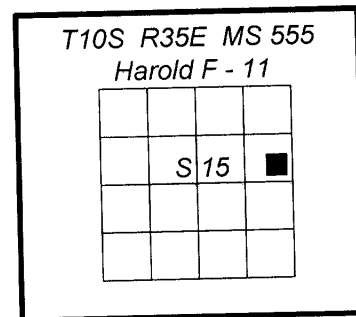


Description of corner evidence found:

Found a 2 ins. diam. iron post with a 2 ins. diam. brass cap, mkd. as shown, projecting 18 ins. above ground, firmly set,
in a 3' diam. stone mound.

from the recovered monument I find the original bearing trees

- A fir snag, 34 ins. diam., bears N. 78° E., 2.4 ft. dist., with visible scribe on open blaze.
- A cut fir stump, 24 ins. diam., bears N. 87° W., 28.0 ft. dist.

Found steel T-post 3 ft. North of monument with Land Survey Monument (54-9) sign.

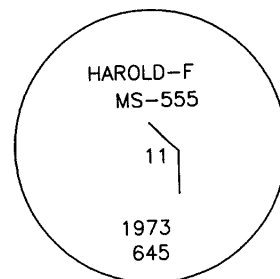

**Description of monument and accessories I established to
perpetuate original location of this corner:**

New bearing trees

- A white fir, 8 ins. diam., bears S. 30° W., 35.4 ft. dist., mkd. HF C11 MS 555 X BT, with washer in face.
- A lodgepole pine, 6 ins. diam., bears N. 37° W., 24.0 ft. dist., mkd. X BT, on double blaze, with washer in face.

NAD 83 CORS '96 geographic position:

Lat. 44°41'57.1" N
Long. 118°28'31.5" W

All bearing trees are painted with red bands, and have Bearing Tree (54-3) and Land Survey
Monument (54-9) signs attached.

Posted National Forest Boundary S. 24°00'25" E. and N. 59°39'34" W. from corner with Property
Boundary (54-2) signs, and a Land Survey Monument (54-9) sign on nearby post.

Witnesses: Matt Brockamp and Dustin Palmer
Date: July 10, 2009

REGISTERED
PROFESSIONAL
LAND SURVEYOR

Ron Walter

OREGON
JANUARY 18, 1994
RON C. WALTER
2648

Renewal Date: June 30, 2010

Office of _____ County Surveyor _____ County of _____ Baker
State of _____ Oregon _____, I hereby certify that the within instrument was filed in this office
for record on the _____ day of _____, 20 ____
_____ by _____
(COUNTY OFFICIAL) (DEPUTY)

FILED Feb. 24, 2010

BAKER COUNTY SURVEYOR

SURVEY NO. 10-35-241