

CERTIFIED RECORD OF LAND CORNER MONUMENTATION

History of original corner establishment:


Deep Gravel Placer Corner #2 Mineral Survey 509

Identical with the S.E. cor. of the location

A pine post 4 ft. long 4 in. square set 6 in. in the ground, to bed rock, with mound of stone, scribed D.G.P. 2-509, whence

A pine 18 in. in diam. bears S. 19 E. 55 ft. blazed and scribed D.G.P. 2-509 B.T.

A pine 30 in. in diam. bears S. 45° 30' W. 31 ft. blazed and scribed D.G.P. 2-509 B.T.

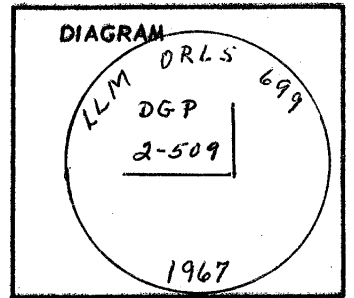

Description of corner evidence found:

Found evidence of rock mound.

Bearing trees: a pine 26 in. in diam. bears S. 55 E. 54.2 ft.

a pine (dead) 28 in. in diam. bears S. 22 W. 30.4 ft.

Description of monument and accessories established to perpetuate the original location of this corner

Set iron rod 5/8 in. x 2 ft. 20 in. in the ground in center of nearly obliterated rock mound

REGISTERED
OREGON
LAND SURVEYOR

Leland Lee Myers

JULY 9, 1965
LELAND LEE MYERS
699

Office of County Surveyor County of Baker
State of Oregon, I hereby certify that the within instrument was filed in this office
for record on the 15 day of September, 1967, at o'clock m., (signed)
..... by Terra Henning
(COUNTY OFFICIAL) (DEPUTY)

SURVEY NO. 10-35 1/2 - 1