

CERTIFIED RECORD OF LAND CORNER MONUMENTATION

History of original corner establishment:


Jordan Placer Corner # 2 Mineral Survey 509

Identical with the S.W. cor. of the location.

A fir post 4.5 ft. long, 4 in. square set 18 in. in the ground scribed J.P. 2-509, whence

A fir 10 in. in diam. bears S. 76°30' W. 9 ft. blazed and scribed J.P. 2-509 B.T.

A fir 24 in. in diam. bears N. 2°30' W. 23 ft. blazed and scribed J.P. 2-509 B.T.

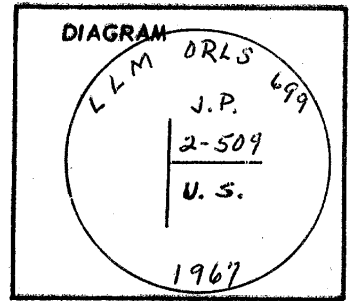

Description of corner evidence found:

Found evidence of original stake and bearing trees.

Bearing trees: a spruce stump 24 in. in diam. bears S. 78 W. 9 ft.
a spruce snag 30 in. in diam. bears N. 4 W. 23.5 ft.

Description of monument and accessories I established to perpetuate the original location of this corner

Set iron rod 5/8 in. x 2 ft. 20 in. in the ground surrounded by rocks.

Reference tree: a fir 6 in. in diam. bears S. 50 W. 24.0 ft.

REGISTERED
OREGON
LAND SURVEYOR

Leland Lee Myers

JULY 9, 1965
LELAND LEE MYERS
699

Office of County Surveyor County of Baker
State of Oregon, I hereby certify that the within instrument was filed in this office
for record on the 15 day of September, 1967, at o'clock m., (signed)
Tom Hanley by
(COUNTY OFFICIAL) (DEPUTY)