


CERTIFIED RECORD OF LAND CORNER MONUMENTATION

History of original corner establishment:

None

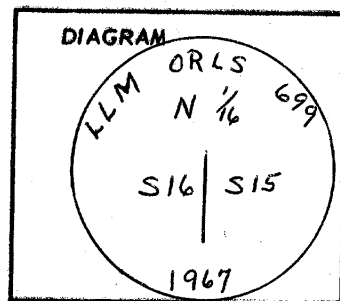

T. 10 S. R. 35 1/2 E

Description of corner evidence found:

None

Description of monument and accessories I established to perpetuate the original location of this corner

Set iron rod 5/8 in. x 2 ft. 18 in. in the ground, surrounded by small rocks.

Reference trees: a pine 16 in. in diam. bears N. 41 E. 11.2 ft.  
a pine 28 in. in diam. bears S. 57 W. 14.0 ft.

Located in a small swale about halfway up hillside on a N. slope.

Timber is primarily small pine.

REGISTERED  
**OREGON**  
LAND SURVEYOR

*Leland Lee Myers*

JULY 9, 1965  
**LELAND LEE MYERS**  
699

Office of County Surveyor County of Baker  
State of Oregon, I hereby certify that the within instrument was filed in this office  
for record on the 15 day of September, 1967, at ..... o'clock .....m., (signed)  
..... by Tom Hawley  
(COUNTY OFFICIAL) (DEPUTY)