


CERTIFIED RECORD OF LAND CORNER MONUMENTATION

History of original corner establishment:

None

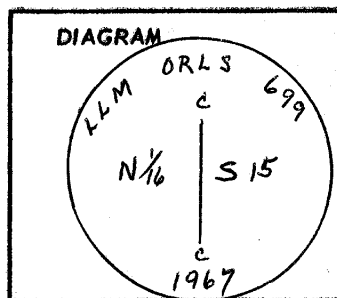

T.10S. R. 35 1/2 E.

Description of corner evidence found:

None

Description of monument and accessories established to perpetuate the original location of this corner

Set iron rod 5/8 in. x 2 ft. 18 in. in the ground with mound of rock on NE side.

Steep N slope.

Reference tree: a W. larch 18 in. in diam. bears N. 37 W. 17.6 ft.

REGISTERED
OREGON
LAND SURVEYOR

Leland Lee Myers

JULY 9, 1965
LELAND LEE MYERS
699

Office of County Surveyor County of Baker
State of Oregon, I hereby certify that the within instrument was filed in this office
for record on the 15 day of September, 1967, at o'clock m., (signed)
..... by Tom Hawley
(COUNTY OFFICIAL) (DEPUTY)

SURVEY NO. 10-35 1/2-6