


CERTIFIED RECORD OF LAND CORNER MONUMENTATION

History of original corner establishment:

None

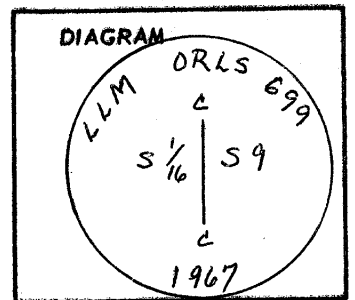

T. 10S. R. 35 1/2 E

Description of corner evidence found:

None

Description of monument and accessories I established to perpetuate the original location of this corner

Set iron rod 5/8 in. x 2 ft. 18 in. in the ground.

Reference trees: a L. pine 6 in. in diam. bears N. 88 W. 17.2 ft.  
a . pine 6 in. in diam. bears S. 42 W. 17.2 ft.

REGISTERED  
OREGON  
LAND SURVEYOR

*Leland Lee Myers*

JULY 9, 1965  
LELAND LEE MYERS  
699

Office of County Surveyor County of Polk  
State of Oregon, I hereby certify that the within instrument was filed in this office  
for record on the 15 day of September, 1967, at        o'clock        m., (signed)  
Tom Handley  
(COUNTY OFFICIAL) by (DEPUTY)

10-35/2-11