


CERTIFIED RECORD OF LAND CORNER MONUMENTATION

History of original corner establishment:

None

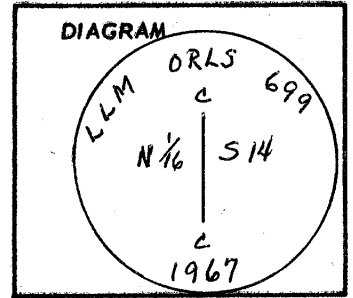

T. 10S. R. 35 1/2 E.

Description of corner evidence found:

None

Description of monument and accessories I established to perpetuate the original location of this corner

Set iron rod 5/8 in. x 2 ft. 18 in. in the ground with rock surrounding it.

Corner located in the bottom of placer mining gully, a solid rock wall of the gully is about 20 ft. to the S.

Scattered pine reproduction.

Reference tree: a pine 6 in. in diam. bears N. 20 W. 4.0 ft.

REGISTERED
OREGON
LAND SURVEYOR

Leland Lee Myers

JULY 9, 1965
LELAND LEE MYERS
699

Office of County Surveyor County of Baker
 State of Oregon, I hereby certify that the within instrument was filed in this office
 for record on the 15 day of September, 1967, at o'clock m., (signed)
 _____ by Tom Hawley
 (COUNTY OFFICIAL) (DEPUTY)

10-35 1/2-13