

**CERTIFIED RECORD OF LAND CORNER MONUMENTATION**

(Reference FSH 5681.65)

History of original corner establishment:


Set Basalt stone 20 x 14 x 10 in. 15 in. in the ground for cor. to Sec's 10, 11, 14, and 15, marked with 2 notches on E and 4 notches on S edges, from which;

A pine 24 in. dia. bears N 50 E, 62 lks. dist., marked T 10 S, R 35 $\frac{1}{2}$  E, S 11 BT.

A pine 30 in. dia. bears S 45 E, 34 lks. dist. marked T 10 S, R 35 $\frac{1}{2}$  E, S 14 BT.

A pine 8 in. dia. bears S 20 W, 54 lks. dist., marked T 10 S, R 35 $\frac{1}{2}$  E, S 15 BT.

A pine 8 in. dia. bears N 70 W, 44 lks. dist., marked T 10 S, R 35 $\frac{1}{2}$  E, S 10 BT.

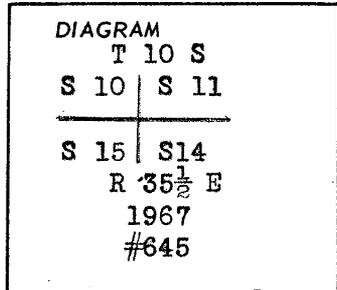

Description of corner evidence found:

Found Basalt stone 20 x 14 x 10 in. laying on the ground, marked with 2 notches on E. and 4 notches on S edges, being the sec. cor. to sec's 10, 11, 14, and 15.

Found pine 38 in. dia. bears S 20 W, 54 lks. dist. marked T 10 S, R 35 $\frac{1}{2}$  E, S 15 BT. (Noted a discrepancy in the copy of original GLO notes.)

Found pine 12 in. dia. bears N 70 W, 44 lks. dist. marked T 10 S, R 35 $\frac{1}{2}$  E, S 10 BT. This tree is dead but standing.

Found pine 26 in. dia. bears N 50 E, 62 lks. dist. marked T 10 S, R 35 $\frac{1}{2}$  E, S 11 BT, dead and on the ground.


No evidence of remaining bearing tree as it is rotted away.

Description of monument and accessories established to perpetuate the original location of this corner

Set a 1 x 30 in. iron pipe with aluminum cap being stamped as shown in the above diagram, placed a mound of stone about corner stone and pipe with dimensions of 3 feet in dia. and 1 $\frac{1}{2}$  feet high.

Placed bearing tree tags on the two standing bearing trees, with the bearing and distance to the corner scribed on the tag.

Placed a corner location poster on another tree with the distance and bearing to the corner scribed on the poster.

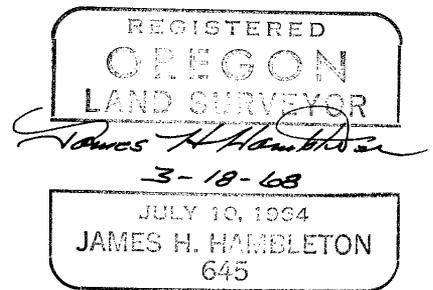

Office of County Surveyor County of Baker  
 State of Oregon, I hereby certify that the within instrument was filed in this office  
 for record on the 28 day of March, 1968, at 5 o'clock P.m., (signed)  
 \_\_\_\_\_ by Tom Hanley  
 (COUNTY OFFICIAL) (DEPUTY)

SURVEY NO. 10-35 $\frac{1}{2}$ -15