


CERTIFIED RECORD OF LAND CORNER MONUMENTATION

(Reference FSH 5681.65)

①

History of original corner establishment:

Set pine post 4 1/2 feet long 5 ins. square, set 18 ins. in the ground, with mound of earth and stone, scribed A. 4-508.

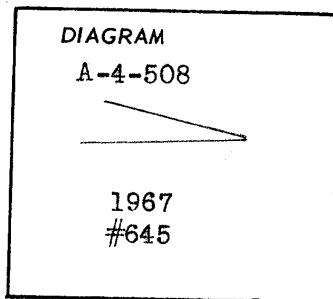

Description of corner evidence found:

Found no evidence of corner, as corner has been covered by the fill slope of an exist ing road.

Description of monument and accessories | established to perpetuate the original location of this corner

Set 1 x 30 in. iron pipe with aluminum cap in a mound of stone, cap being stamped as shown in above diagram.

REGISTERED
OREGON
LAND SURVEYOR
James H. Hambleton
3-18-68
JULY 10, 1964
JAMES H. HAMBLETON,
645

Office of County Surveyor County of Baker
State of Oregon, I hereby certify that the within instrument was filed in this office
for record on the 28 day of March, 1968 at 5 o'clock p.m., (signed)
..... by Tom Hawley
(COUNTY OFFICIAL) (DEPUTY)