

CERTIFIED RECORD OF LAND CORNER MONUMENTATION

(Reference FSH 5681.65)


2

History of original corner establishment:

Set pine post $4\frac{1}{2}$ feet long 4 ins. square, set 18 ins. in the ground, scribed A. 3-508 whence;

A pine 18 ins. dia. bears S 87 30 W 29 feet blazed and scribed A. 3-508 B.T.

A pine 24 in. dia. bears S 17 E 44 feet blazed and scribed A. 3-508 B.T.

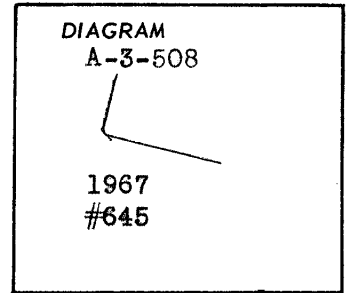

Description of corner evidence found:

Found no evidence of wooden post.

Found two stumps, though badly rotted, fitting the descriptions of the two bearing trees and checking to the bearings and distances to the corner.

Description of monument and accessories established to perpetuate the original location of this corner

Set 1 x 30 in. iron pipe with aluminum cap in a mound of stone, cap being stamped as shown in above diagram.

REGISTERED
OREGON
LAND SURVEYOR

James H. Hambleton
3-18-68

JULY 10, 1964
JAMES H. HAMBLETON
645

Office of County Surveyor County of Baker
State of Oregon, I hereby certify that the within instrument was filed in this office
for record on the 28 day of March, 1968, at 5 o'clock P.m., (signed)
..... by Tom Hardy
(COUNTY OFFICIAL) (DEPUTY)

COPY 10-35 1/2-18