


CERTIFIED RECORD OF LAND CORNER MONUMENTATION

(Reference FSH 5681.65)

3

History of original corner establishment:

Set pine post 4½ feet long 6 ins. square, set 18 ins. in the ground, with mound of earth, scribed P. 1-508.

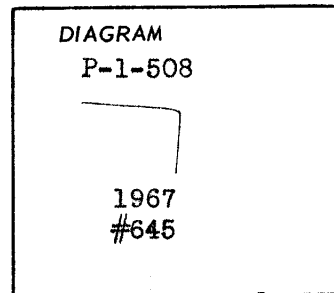


Description of corner evidence found:

Found evidence of small stone being in a mound of earth and stone, no evidence of post.

Description of monument and accessories I established to perpetuate the original location of this corner

Set 1 x 30 in. iron pipe with aluminum cap in a mound of stone, cap being stamped as shown in above diagram.

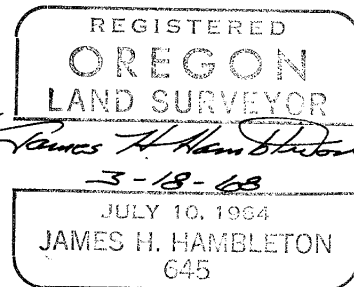

Office of County Surveyor County of Baker  
 State of Oregon, I hereby certify that the within instrument was filed in this office  
 for record on the 28 day of March, 1968, at 5 o'clock P.m., (signed)  
 \_\_\_\_\_ by Tom Hawley  
 (COUNTY OFFICIAL) (DEPUTY)