


CERTIFIED RECORD OF LAND CORNER MONUMENTATION

(Reference FSH 5681.65)

4

History of original corner establishment:

Set wooden post for corner #5 of the Crown Point mining claim,  
Mineral Survey #508.

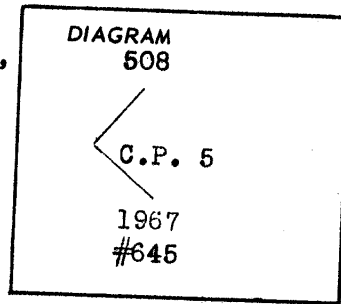

Description of corner evidence found:

Made extensive search but could not find corner post or any evidence of a corner.

Description of monument and accessories I established to perpetuate the original location of this corner

Set 1 x 30 in. iron pipe with aluminum cap in a mound of stone and cap being stamped as shown in the above diagram.

REGISTERED  
OREGON  
LAND SURVEYOR  
*James H. Hambleton*  
3-16-68  
JULY 10, 1964  
JAMES H. HAMBLETON  
645

Office of *County Surveyor* County of *Baker*  
State of *Oregon*, I hereby certify that the within instrument was filed in this office  
for record on the *28* day of *March*, 19*68* at *5* o'clock *p.m.*, (signed)  
..... by *Tom Hanley*  
(COUNTY OFFICIAL) (DEPUTY)