


CERTIFIED RECORD OF LAND CORNER MONUMENTATION

(Reference FSH 5681.65)

5

History of original corner establishment:

Set Fir post $4\frac{1}{2}$ feet 5 ins. square set 18 ins. in the ground with mound of earth and stone, scribed P. 3-508.

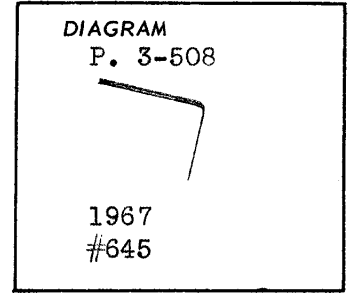


Description of corner evidence found:

Found mound of stone with no evidence of any post.

Description of monument and accessories I established to perpetuate the original location of this corner

Set 1 x 30 in. iron pipe with aluminum cap in mound of stone, cap being stamped as shown in above diagram.

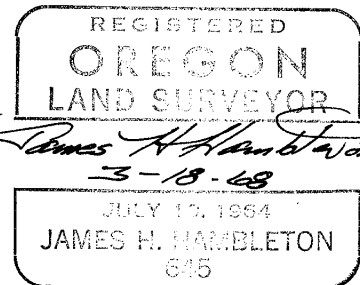

Office of County Surveyor County of Baker
 State of Oregon, I hereby certify that the within instrument was filed in this office
 for record on the 28 day of March, 1968, at 5 o'clock P.m., (signed)
 _____ by Tom Hanley
 (COUNTY OFFICIAL) (DEPUTY)