

CERTIFIED RECORD OF LAND CORNER MONUMENTATION

(Reference FSH 5681.65)


6

History of original corner establishment:

Set post 4 1/2 feet long 4 in. square, set 18 in. in the ground with mound of earth scribed 2-332.

A pine 2 ft. dia. bears S 73 #0 E, 4 ft. blazed and scribed 2-332 BT.

A pine 3 ft. dia. bears S 61 W, 16 ft. blazed and scribed 2-332 BT.

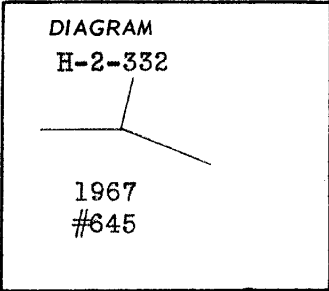

Description of corner evidence found:

Found mound of earth with rotten wood in the mound.


Found pine 38 in. dia. bears S 61 E, 16 feet instead of the prescribed in above notes, blazed and scribed 2-332 BT.

Found pine badly rotted not able to read any scribing, bears S74 W, 40 ft. instead of the prescribed in above notes.

Description of monument and accessories established to perpetuate the original location of this corner

Set 1 x 30 in. iron pipe with aluminum cap in mound of stone, cap being stamped as shown in above diagram.

Placed Mineral Survey bearing tree tags on the one remaining live tree, with the corrected bearing and distance to the corner scribed on the tag.

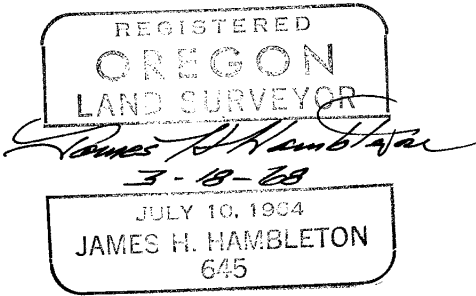

Office of County Surveyor County of Baker
 State of Oregon, I hereby certify that the within instrument was filed in this office
 for record on the 28 day of March, 1968, at 5 o'clock P.m., (signed)
 _____ by Tom Hanley
 (COUNTY OFFICIAL) (DEPUTY)