

CERTIFIED RECORD OF LAND CORNER MONUMENTATION

(Reference FSH 5681.65)


7

History of original corner establishment:

Set post $4\frac{1}{8}$ feet long 4 in. square, set 18 in. in the ground with mound of earth, scribed 2-332.

A White Fir 12 in. dia. bears N 50 20 W, 41.5 feet blazed and scribed 2-332 BT.

A Tamarack 12 in. dia. bears N 30 45 W, 27 feet blazed and scribed 2-332 BT.

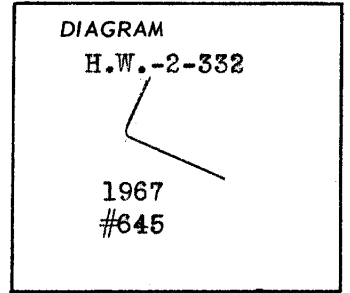

Description of corner evidence found:

Found no evidence of post or mound of earth.


White Fir has completely rotted away leaving no trace of existence.

Found Tamarack 16 in. dia. bears N 30 45 W, 27 feet blazed and scribed 2-332 BT.

Description of monument and accessories established to perpetuate the original location of this corner

Set 1 x 30 in. iron pipe with aluminum cap in mound of stone, cap being stamped as shown in above diagram.

Placed Mineral Survey bearing tree tags on the one remaining bearing tree, with the bearing and distance to the corner, scribed on the tags.

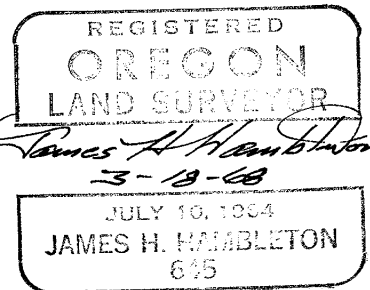

Office of County Surveyor County of Baker
 State of Oregon, I hereby certify that the within instrument was filed in this office
 for record on the 28 day of March, 1968, at 5 o'clock P.m., (signed)
 _____ by Tom Huley
 (COUNTY OFFICIAL) (DEPUTY)

SURVEY NO. 10-35 1/2-23