

CERTIFIED RECORD OF LAND CORNER MONUMENTATION

(Reference FSH 5681.65)


②

History of original corner establishment:

Set post  $4\frac{1}{2}$  feet long 4 in. square, set 18 in. in the ground, with mound of earth scribed 1-332 whence;

A White Fir 30 in. in dia. bears N 34 15 W, 6.5 feet blazed and scribed 1-332 BT.

A White Fir 15 in. in dia. bears N 02 30 E, 16.5 feet blazed and scribed 1-332 BT.

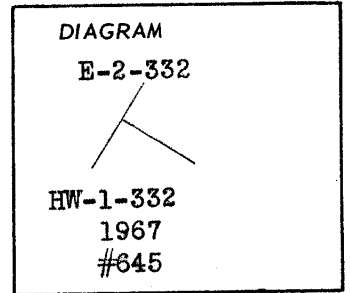

Description of corner evidence found:

Found no evidence of post or mound of earth.


Found old rotted tree, unable to read any markings though it checked to bearing N 02 30 E but the distance was 6.5 feet.

Found White Fir 34 in. dia. bears N 34 15 W, but the distance was 16.5 feet and scribed 1-332 BT.

Description of monument and accessories established to perpetuate the original location of this corner

Set 1 x 30 in. iron pipe with aluminum cap in mound of stone, cap being stamped as shown in above diagram.

Placed Mineral Survey bearing tree tag on the bearing tree, with the bearing and distance to the corner, scribed on the tags.

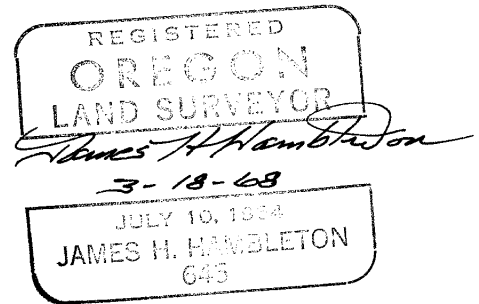

Office of County Surveyor County of Baker  
 State of Oregon, I hereby certify that the within instrument was filed in this office  
 for record on the 28 day of March, 1968, at 5 o'clock P.m., (signed)  
 \_\_\_\_\_ by Tom Hanley  
 (COUNTY OFFICIAL) (DEPUTY)

10-35 1/2-24